

LETTER OF TRANSMITTAL



1780 Oakdale Avenue San Francisco CA 94124 license #797773
 phone (415) 255-1506 fax (415) 255-1508 www.roebucksf.com

Date	20-Sept-18	Job No.	515
Attention	Steve Ryder		
Re:	<p style="text-align: center;">UC Hastings College of Law Infrastructure Improvements</p> <p style="text-align: center;">Submittal #009B - Window Washing Davit Arms</p>		

TO **MK Think Architects**

1500 Sansome Street,

San Francisco, CA 94111

WE ARE SENDING YOU THE FOLLOWING: Attached Email
 Shop Drawings Prints Plans Specifications
 Copy of Letter Change Order Submittal _____

Copies	Date	No.	Description
1	20-Sept-18		Window Washing Davit Arms Submittal

For approval Approved as submitted Resubmit _____ copies for approval
 For your files Approved as noted For review and comments
 As requested Returned for corrections FOR BIDS DUE _____

REMARKS:

Signed Barry Doherty Contracts Administrator

Copy To

Barry Doherty, PM

LETTER OF TRANSMITTAL

DATE: 9/19/2018

PROJECT: UC HASTINGS

ATTENTION TO:

BARRY DOHERTY
ROEBUCK CONSTRUCTION
415-255-1506

SUBMITTED BY:

MATT BEIER
PERMANENT INSTALLATIONS ENGINEER – SKY CLIMBER, I
1800 PITTSBURGH DRIVE
DELAWARE, OH 43015
740-203-3925

ARCH. LOG No. 17013 - SU 009B		
RESUBMIT FOR REVIEW	THIS SUBMITTAL HAS BEEN CHECKED ONLY FOR CONFORMANCE WITH THE DESIGN CONCEPT OF THE PROJECT AND COMPLIANCE WITH THE INFORMATION GIVEN IN THE CONSTRUCTION DOCUMENTS. THE CHECKING OF THIS SUBMITTAL SHALL NOT RELIEVE THE CONTRACTOR FROM THE RESPONSIBILITY FOR DEVIATIONS FROM THE DRAWINGS OR SPECIFICATIONS UNLESS HE HAS IN WRITING CALLED THE ARCHITECTS ATTENTION TO SUCH DEVIATIONS AND SECURED HIS WRITTEN APPROVAL. NOR SHALL IT RELIEVE HIM FROM THE RESPONSIBILITY FOR ERRORS ON THIS SUBMITTAL.	REVIEW COMPLETED
X REVISE AND/OR CORRECT		NO CORRECTIONS NOTED
REJECTED		MAKE CORRECTIONS NOTED
DATE 10/8/18	McGINNIS CHEN ASSOCIATES, INC. 1019 MISSION STREET SAN FRANCISCO, CA 94103 415-986-3873	BY WHOM ER
DATE		BY WHOM

ENCLOSED:

COPIES	DWG NO.	REV.	DESCRIPTION
1	SCL 1.0	C	ROOF EQUIPMENT LAYOUT
1	SCL 2.0	B	DAVIT DETAIL
1	SCL 2.1	A	DAVIT ASSEMBLY DETAILS
1	SCL 3.0	A	DAVIT BASE WELD CALCULATIONS
1	N/A	A	DAVIT MOBILE SOCKET CALCULATIONS
1	N/A	A	ROOF RIGGED DAVIT ARM CALCULATIONS

SUBMITTAL STATUS:


- FOR APPROVAL
 FOR RECORD ONLY

PLEASE PROVIDE A RESPONSE TO THIS SUBMITTAL ON OR BEFORE 9/25/2018.



Per MCA Stamp - Revise and Resubmit

REVIEWED		
NO CORRECTIONS NOTED	CORRECTIONS NOTED	X
REVISE AND RESUBMIT	REJECTED	
BY RJH	DATE 10/8/18	
<small>THIS IS A GENERAL REVIEW ONLY. FOR COMPLIANCE WITH THE PLANS AND SPECIFICATIONS, AND DOES NOT CONSTITUTE A DETAILED CHECK OF DIMENSIONS, QUANTITIES, MATERIALS OR FABRICATION PROCESSES. THIS REVIEW SHALL NOT RELIEVE THE CONTRACTOR, SUB-CONTRACTOR OR VENDOR FROM CONFORMING WITH ALL ASPECTS OF THE PLANS AND SPECIFICATIONS, AND NEITHER THE ENGINEER NOR OWNER SHALL BE HELD RESPONSIBLE FOR ANY ERRORS OR OMISSIONS BY REASON OF THIS REVIEW.</small>		
JYASF, INC. STRUCTURAL ENGINEERS 1 KAISER PLAZA, SUITE 405, OAKLAND, CA		

Per MCA Stamp - Revise and Resubmit

SR5 Safety Services Inc.		
<input type="checkbox"/> REVIEWED	<input checked="" type="checkbox"/> REVIEWED AS NOTED	
<input type="checkbox"/> REVISE AND RESUBMIT	<input type="checkbox"/> REJECTED	
<input type="checkbox"/> FOR INFORMATION ONLY	<small>This submittal has been reviewed for general conformance with the contract requirements only. The subcontractor is responsible for conforming to and completing all quantities, dimensions, fabrication, construction methods and coordination of this work with all other trades. This review does not relieve the subcontractor of their responsibilities to comply with the contract obligations and performance specifications.</small>	
BY RS	DATE 09-28-2018	

1800 PITTSBURGH DRIVE, DELAWARE, OHIO 43015
TOLL FREE: 800-255-4629, DIRECT TEL: 740-203-3900, FAX: 740-203-3901
EMAIL: info@skyclimber.com

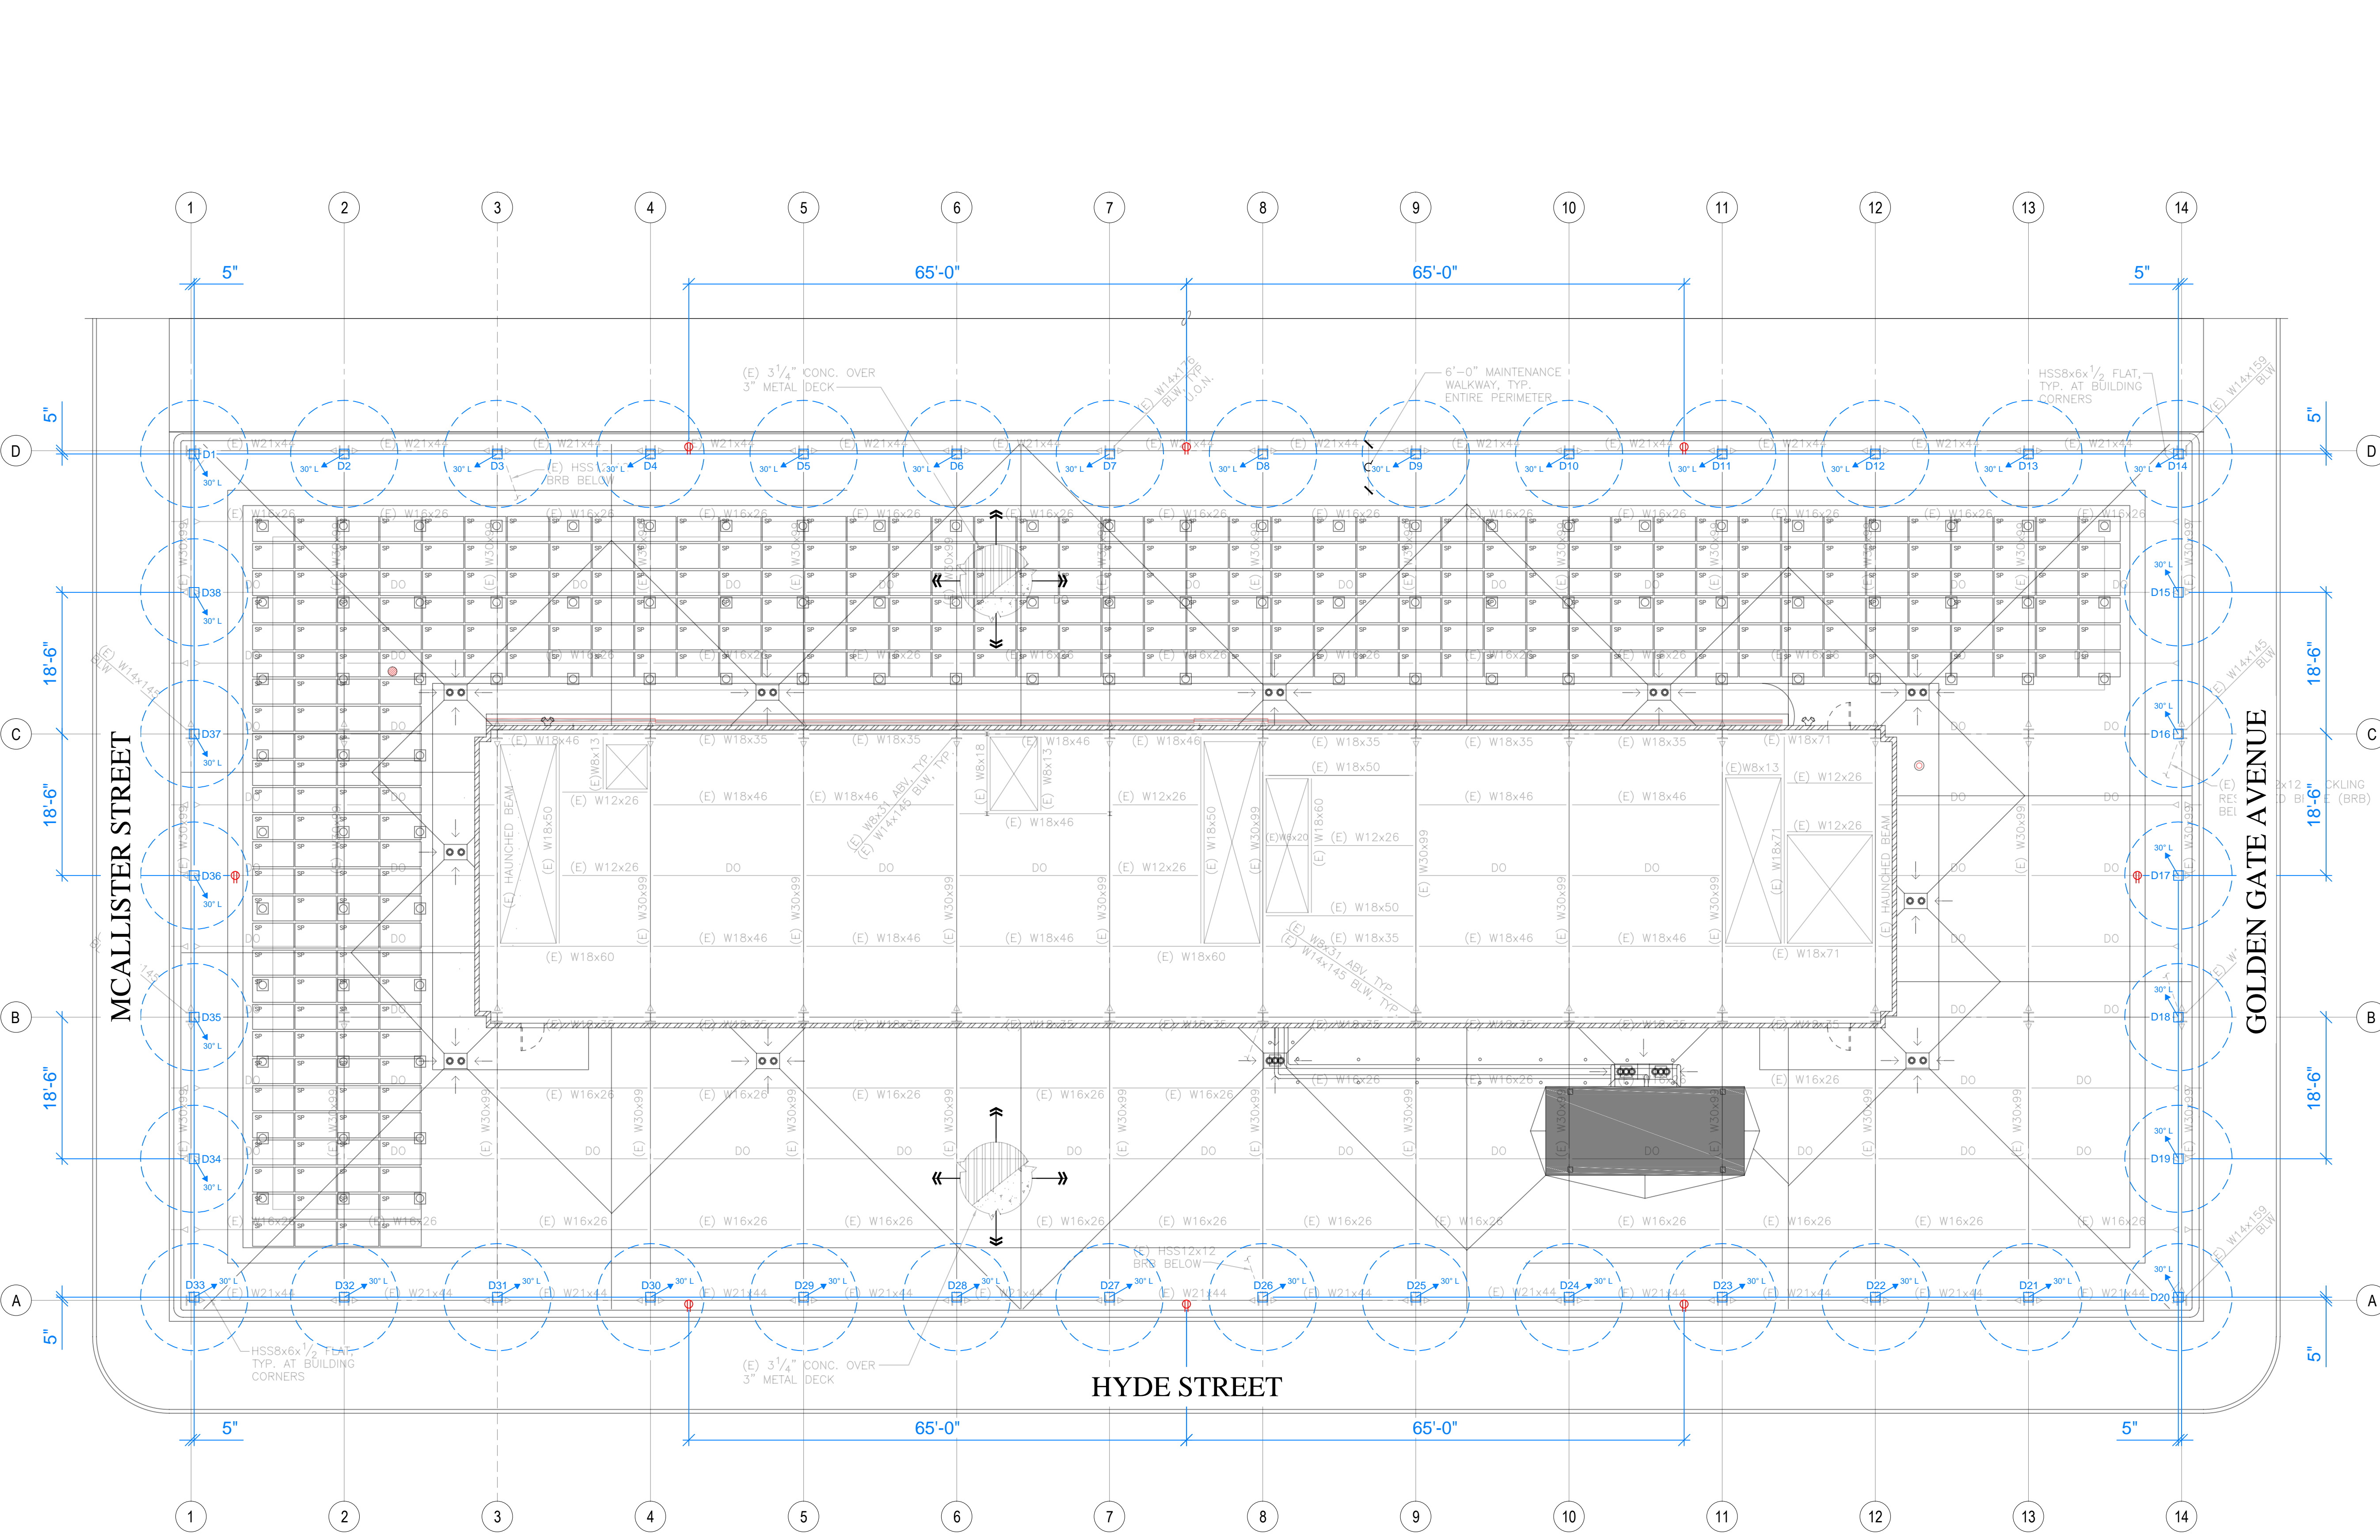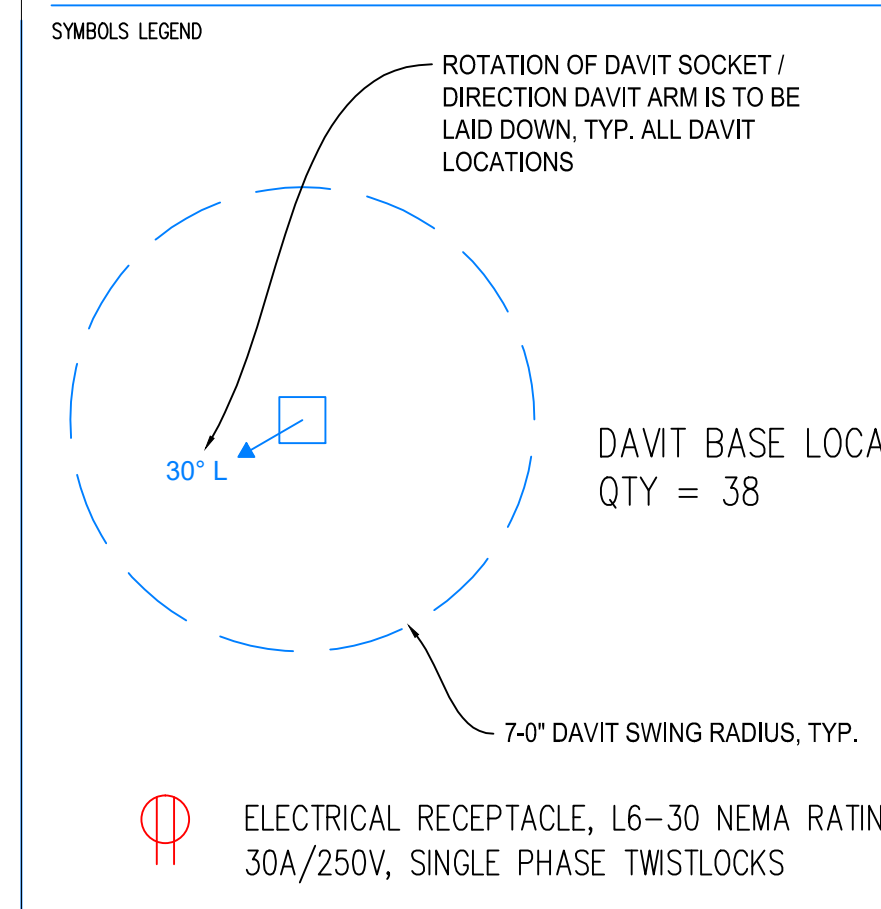

SKY CLIMBER
ACCESS INNOVATIONS SINCE 1955

Sky Climber®, LLC
1800 Pittsburgh Drive, Delaware, OH 43015
Toll Free: 800.255.4629 Ph: 740.203.3900 Fax: 740.203.3901
E-mail: info@skyclimber.com Web: www.skyclimber.com

PROJECT

UC HASTINGS
SAN FRANCISCO, CA

SHEET TITLE

ROOF EQUIPMENT LAYOUT

REVISIONS


REV.	DESCRIPTION	DATE	REV. BY
A	INITIAL RELEASE	1-30-18	MB
B	UPDATED DAVIT ROTATIONS AND LOCATIONS	6-4-18	NK
C	ADDED ELECTRICAL RECEPTACLES	9-20-18	MB

DATE: 6-4-18 DRAWN BY: NK

SCALE: CHECKED BY:


PROJECT #:

SHEET # SCL 1.0 REVISION # B

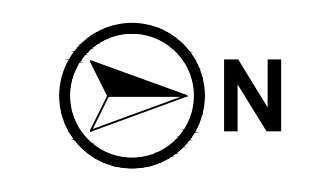


THE INFORMATION CONTAINED IN THIS DRAWING IS THE SOLE PROPERTY OF SKY CLIMBER. ANY REPRODUCTION IN PART OR WHOLE WITHOUT THE WRITTEN PERMISSION OF SKY CLIMBER IS PROHIBITED. OTHERWISE STATED DIMENSIONS ARE IN INCH TOL. +/- .1" UNLESS OTHERWISE STATED. (GENERATED DRAWING DO NOT SCALE. DO NOT MANUALLY UPDATE)

IMPOSED LOADS ON DAVIT BASE:
 MAX MOMENT = 35,620 FT-LBS
 MAX VERTICAL LOAD = 5,000 LBS

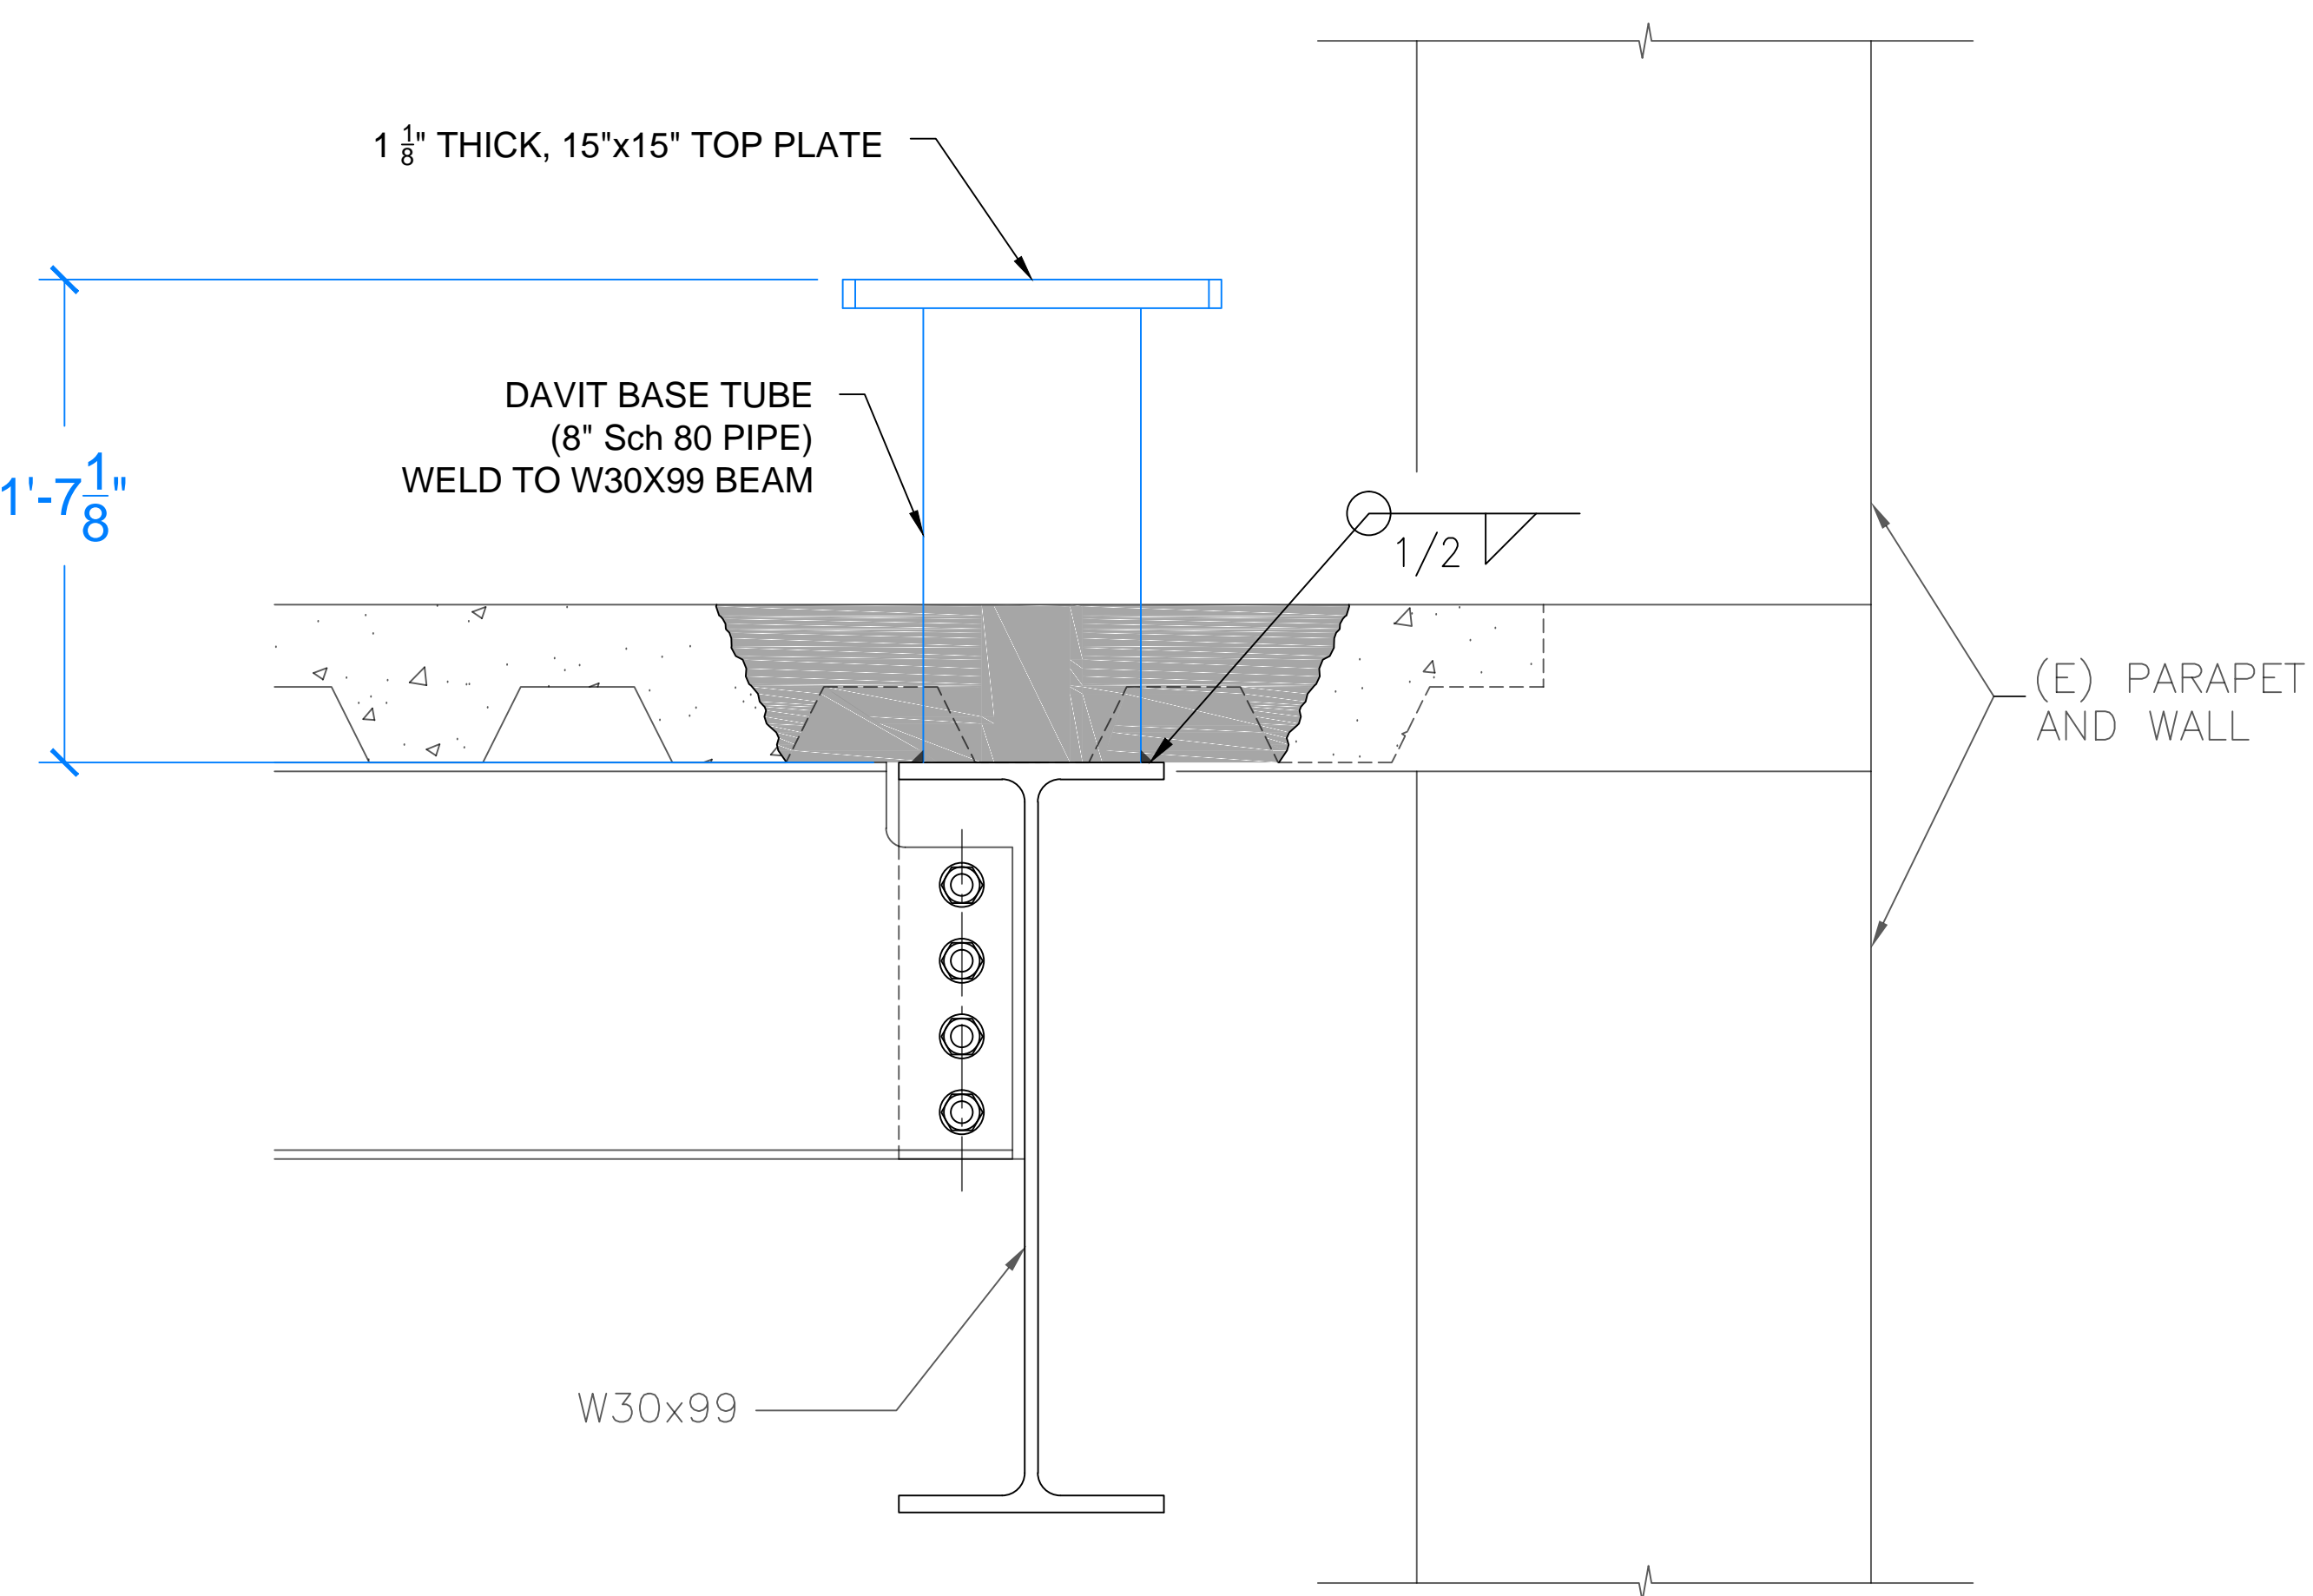

1 TYP. DAVIT DETAIL AT W30 BEAM

IMPOSED LOADS ON DAVIT BASE:
 MAX MOMENT = 35,620 FT-LBS
 MAX VERTICAL LOAD = 5,000 LBS

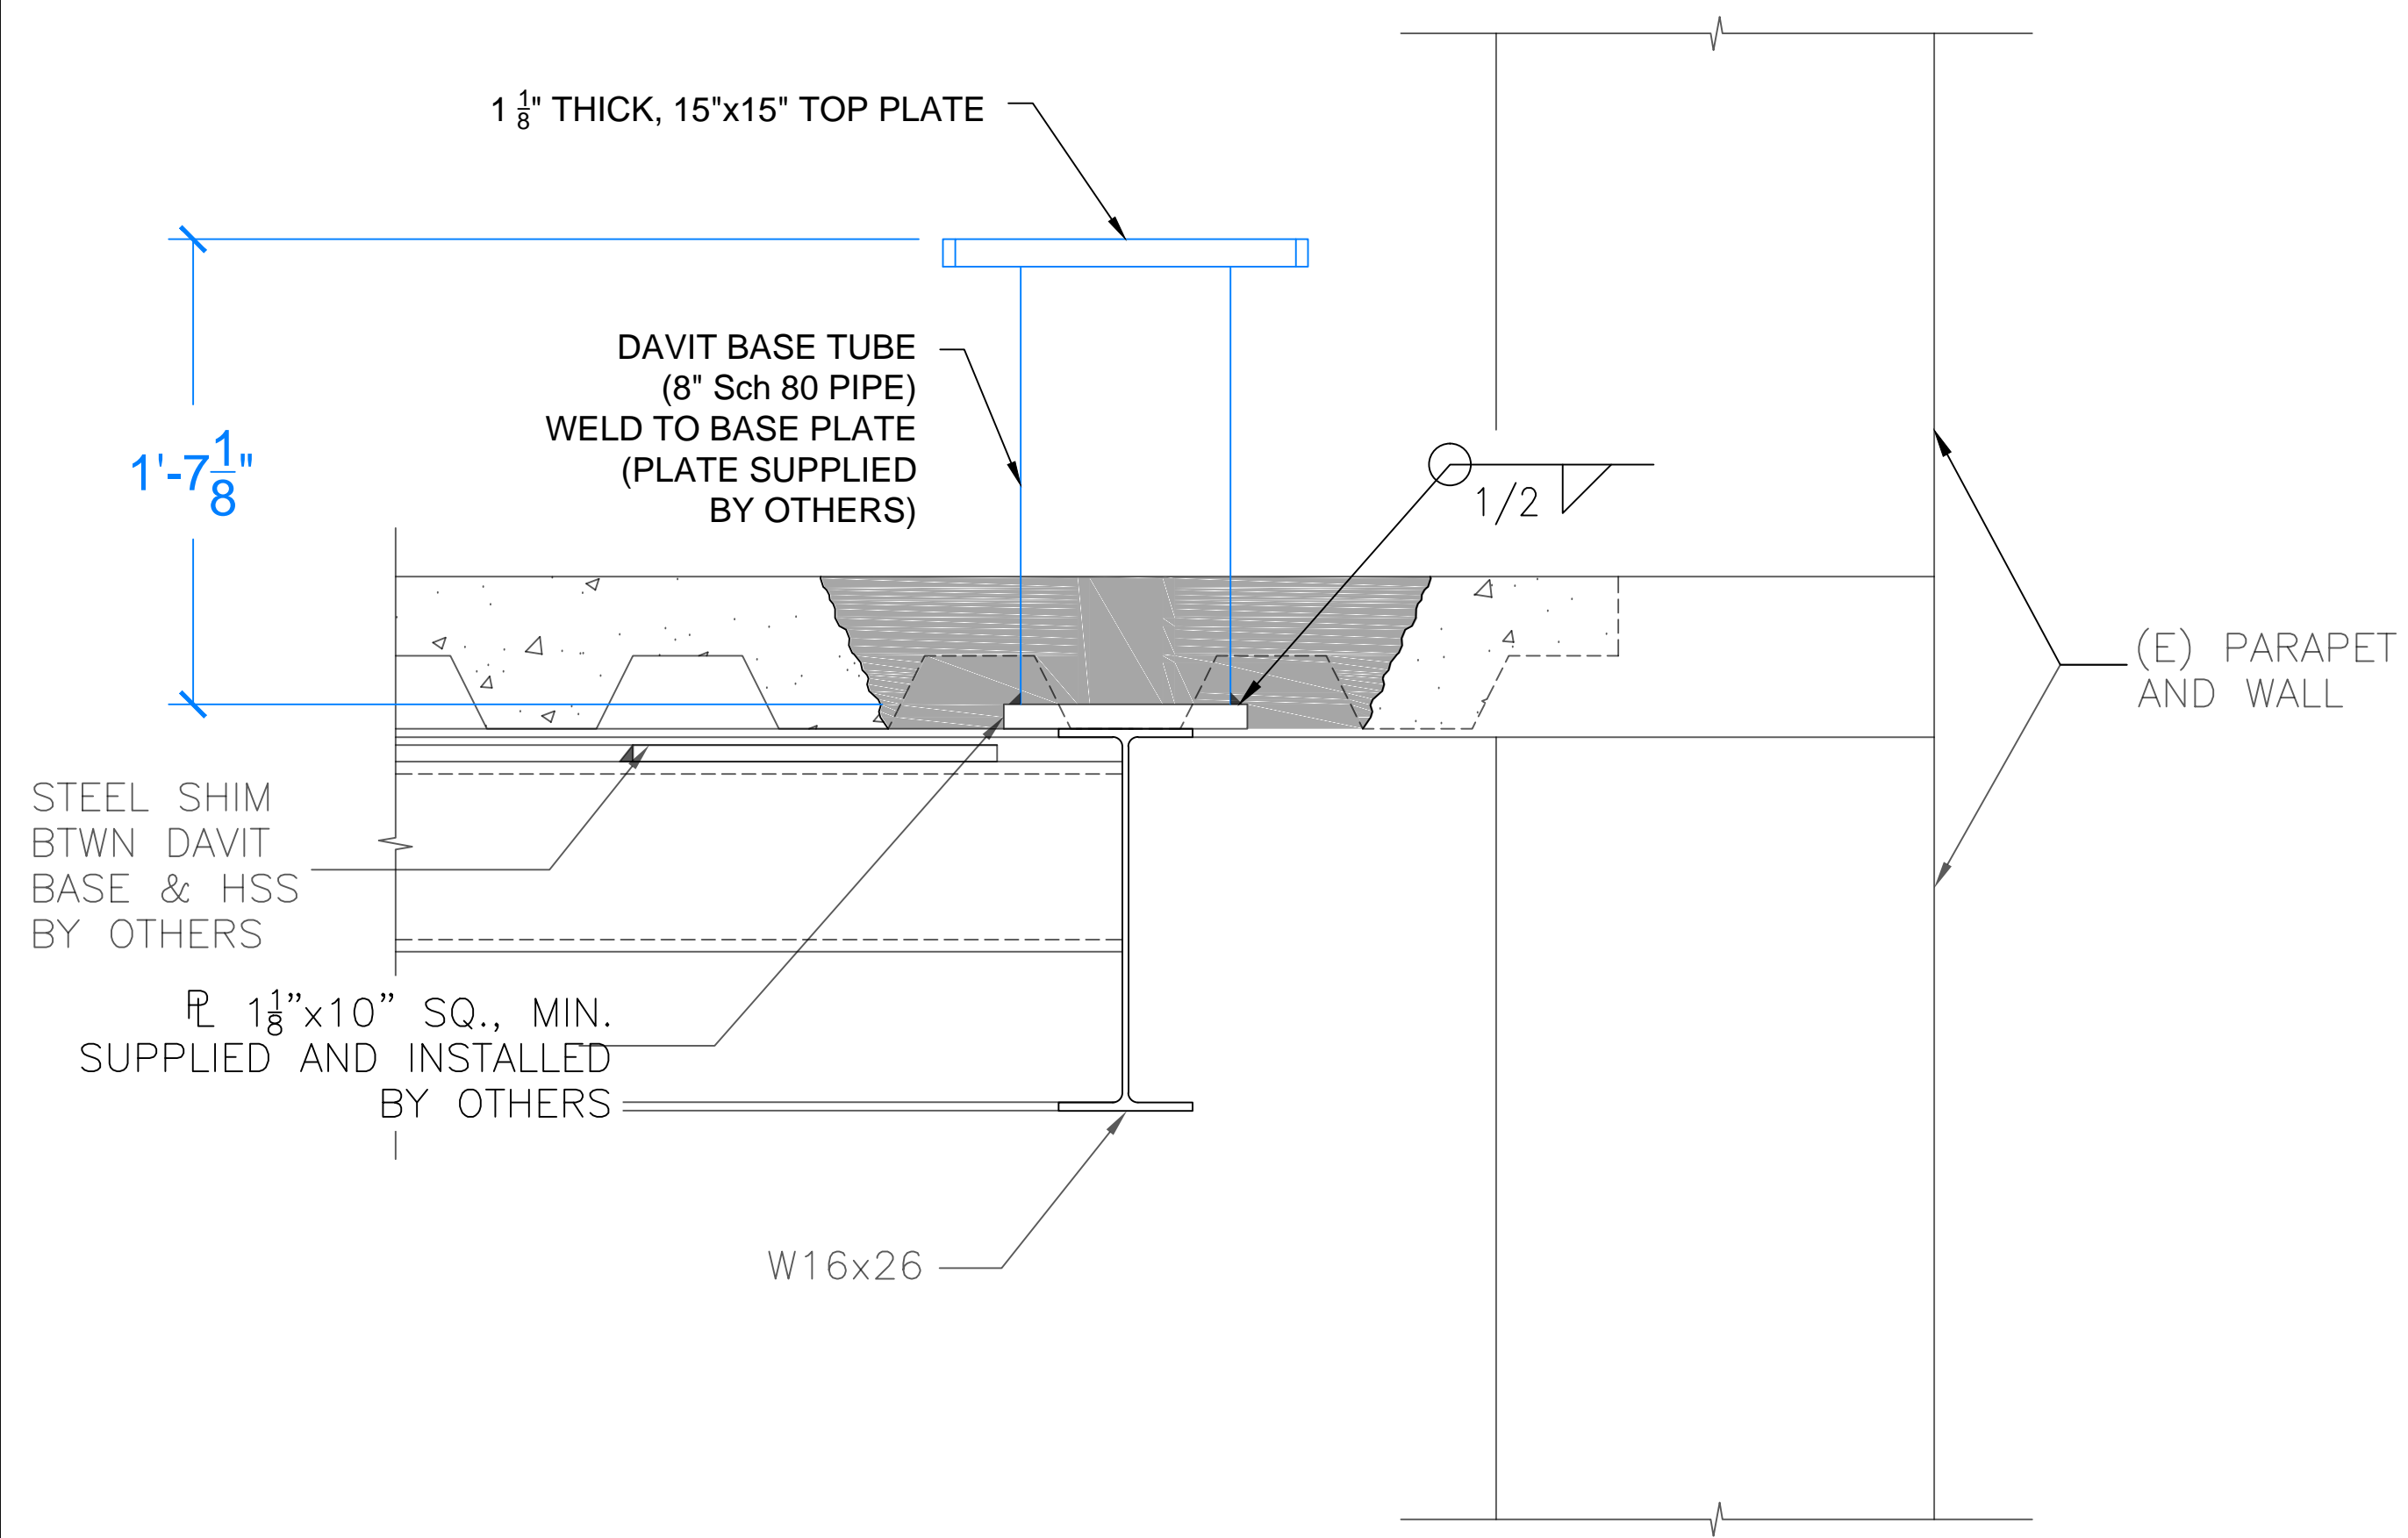

2 TYP. DAVIT DETAIL AT W16 BEAM

This sheet is outdated. A revised sheet dated 6-5-18 was provided as part of RFI #009. The revised sheet should be included rather than this outdated version.

SYMBOLS LEGEND



Sky Climber®, LLC
 1800 Pittsburgh Drive, Delaware, OH 43015
 Toll Free: 800.255.4629 Ph: 740.203.3900 Fax: 740.203.3901
 E-mail: info@skyclimber.com Web: www.skyclimber.com

PROJECT

UC HASTINGS
 SAN FRANCISCO, CA

SHEET TITLE


DAVIT DETAIL

REVISIONS


REV.	DESCRIPTION	DATE	REV. BY
A	INITIAL RELEASE	1-30-18	MB
B	UPDATED BASE DETAILS, CALLED OUT BEAM SIZE	2-13-18	MB

DATE:	1-30-18	DRAWN BY:	MB
SCALE:		CHECKED BY:	
PROJECT #:			
SHEET #:	SCL 2.0	REVISION #:	B

7'-0" ARM REACH

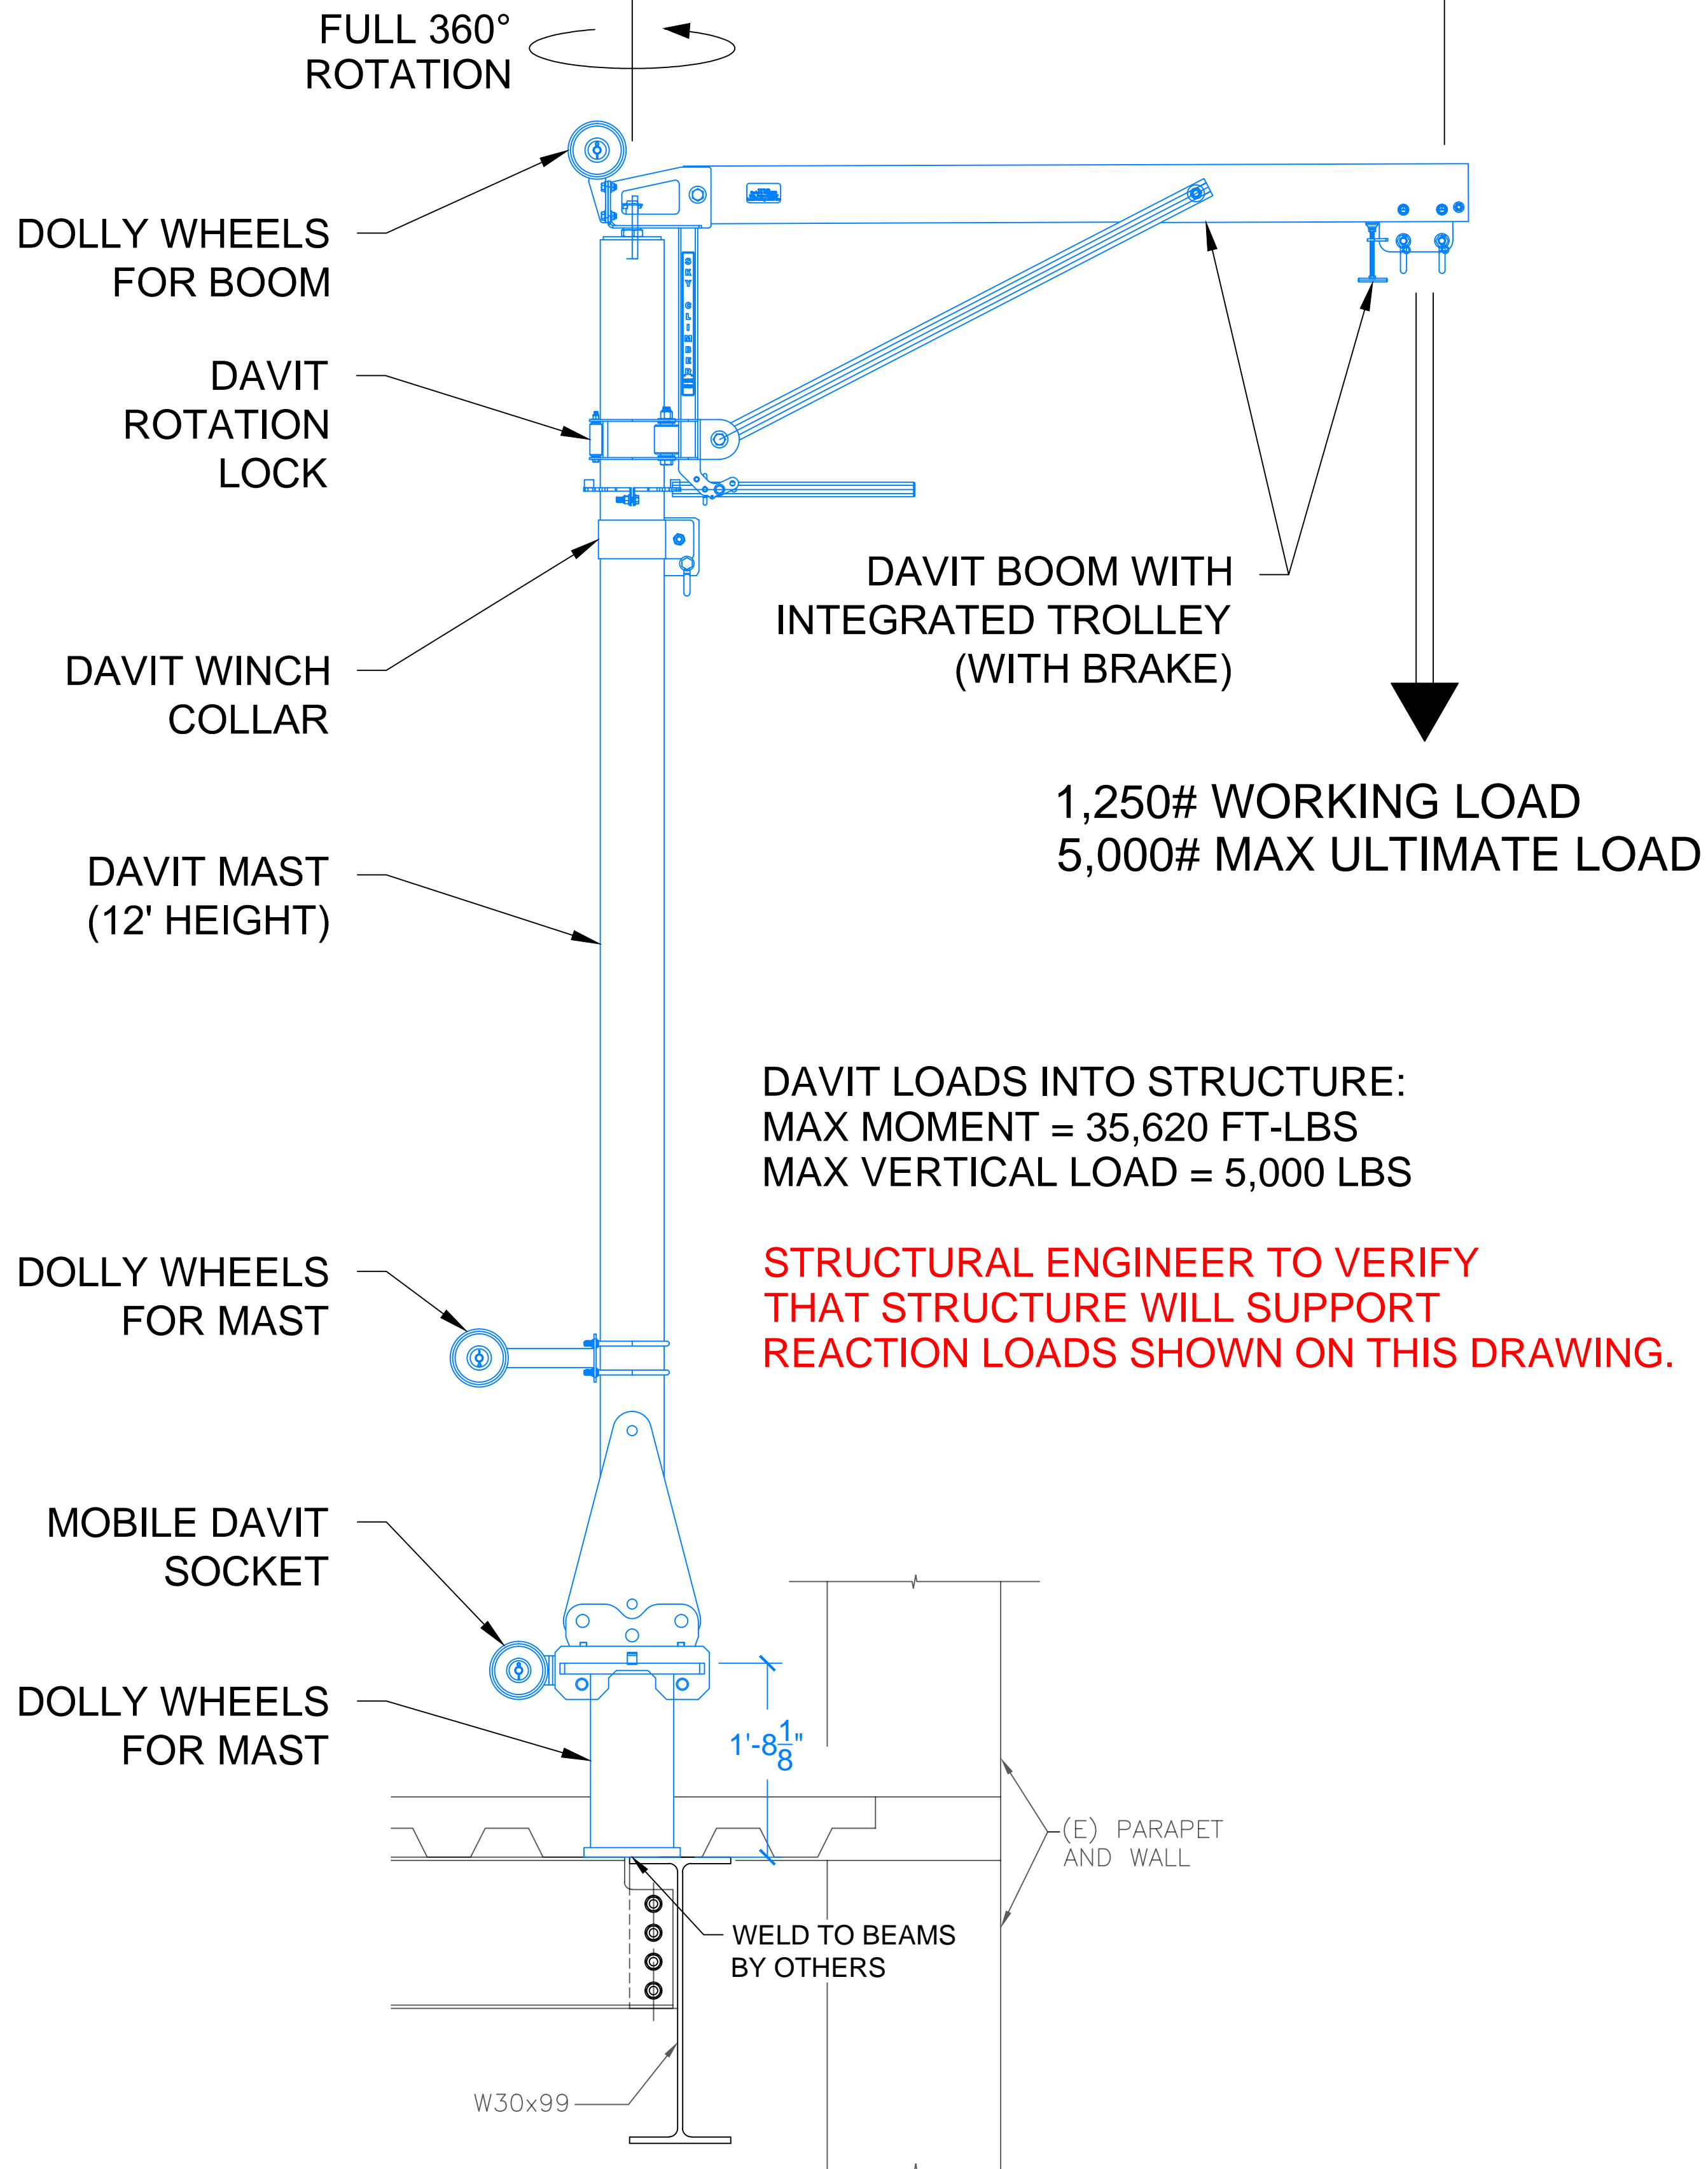

7'-0" ARM REACH

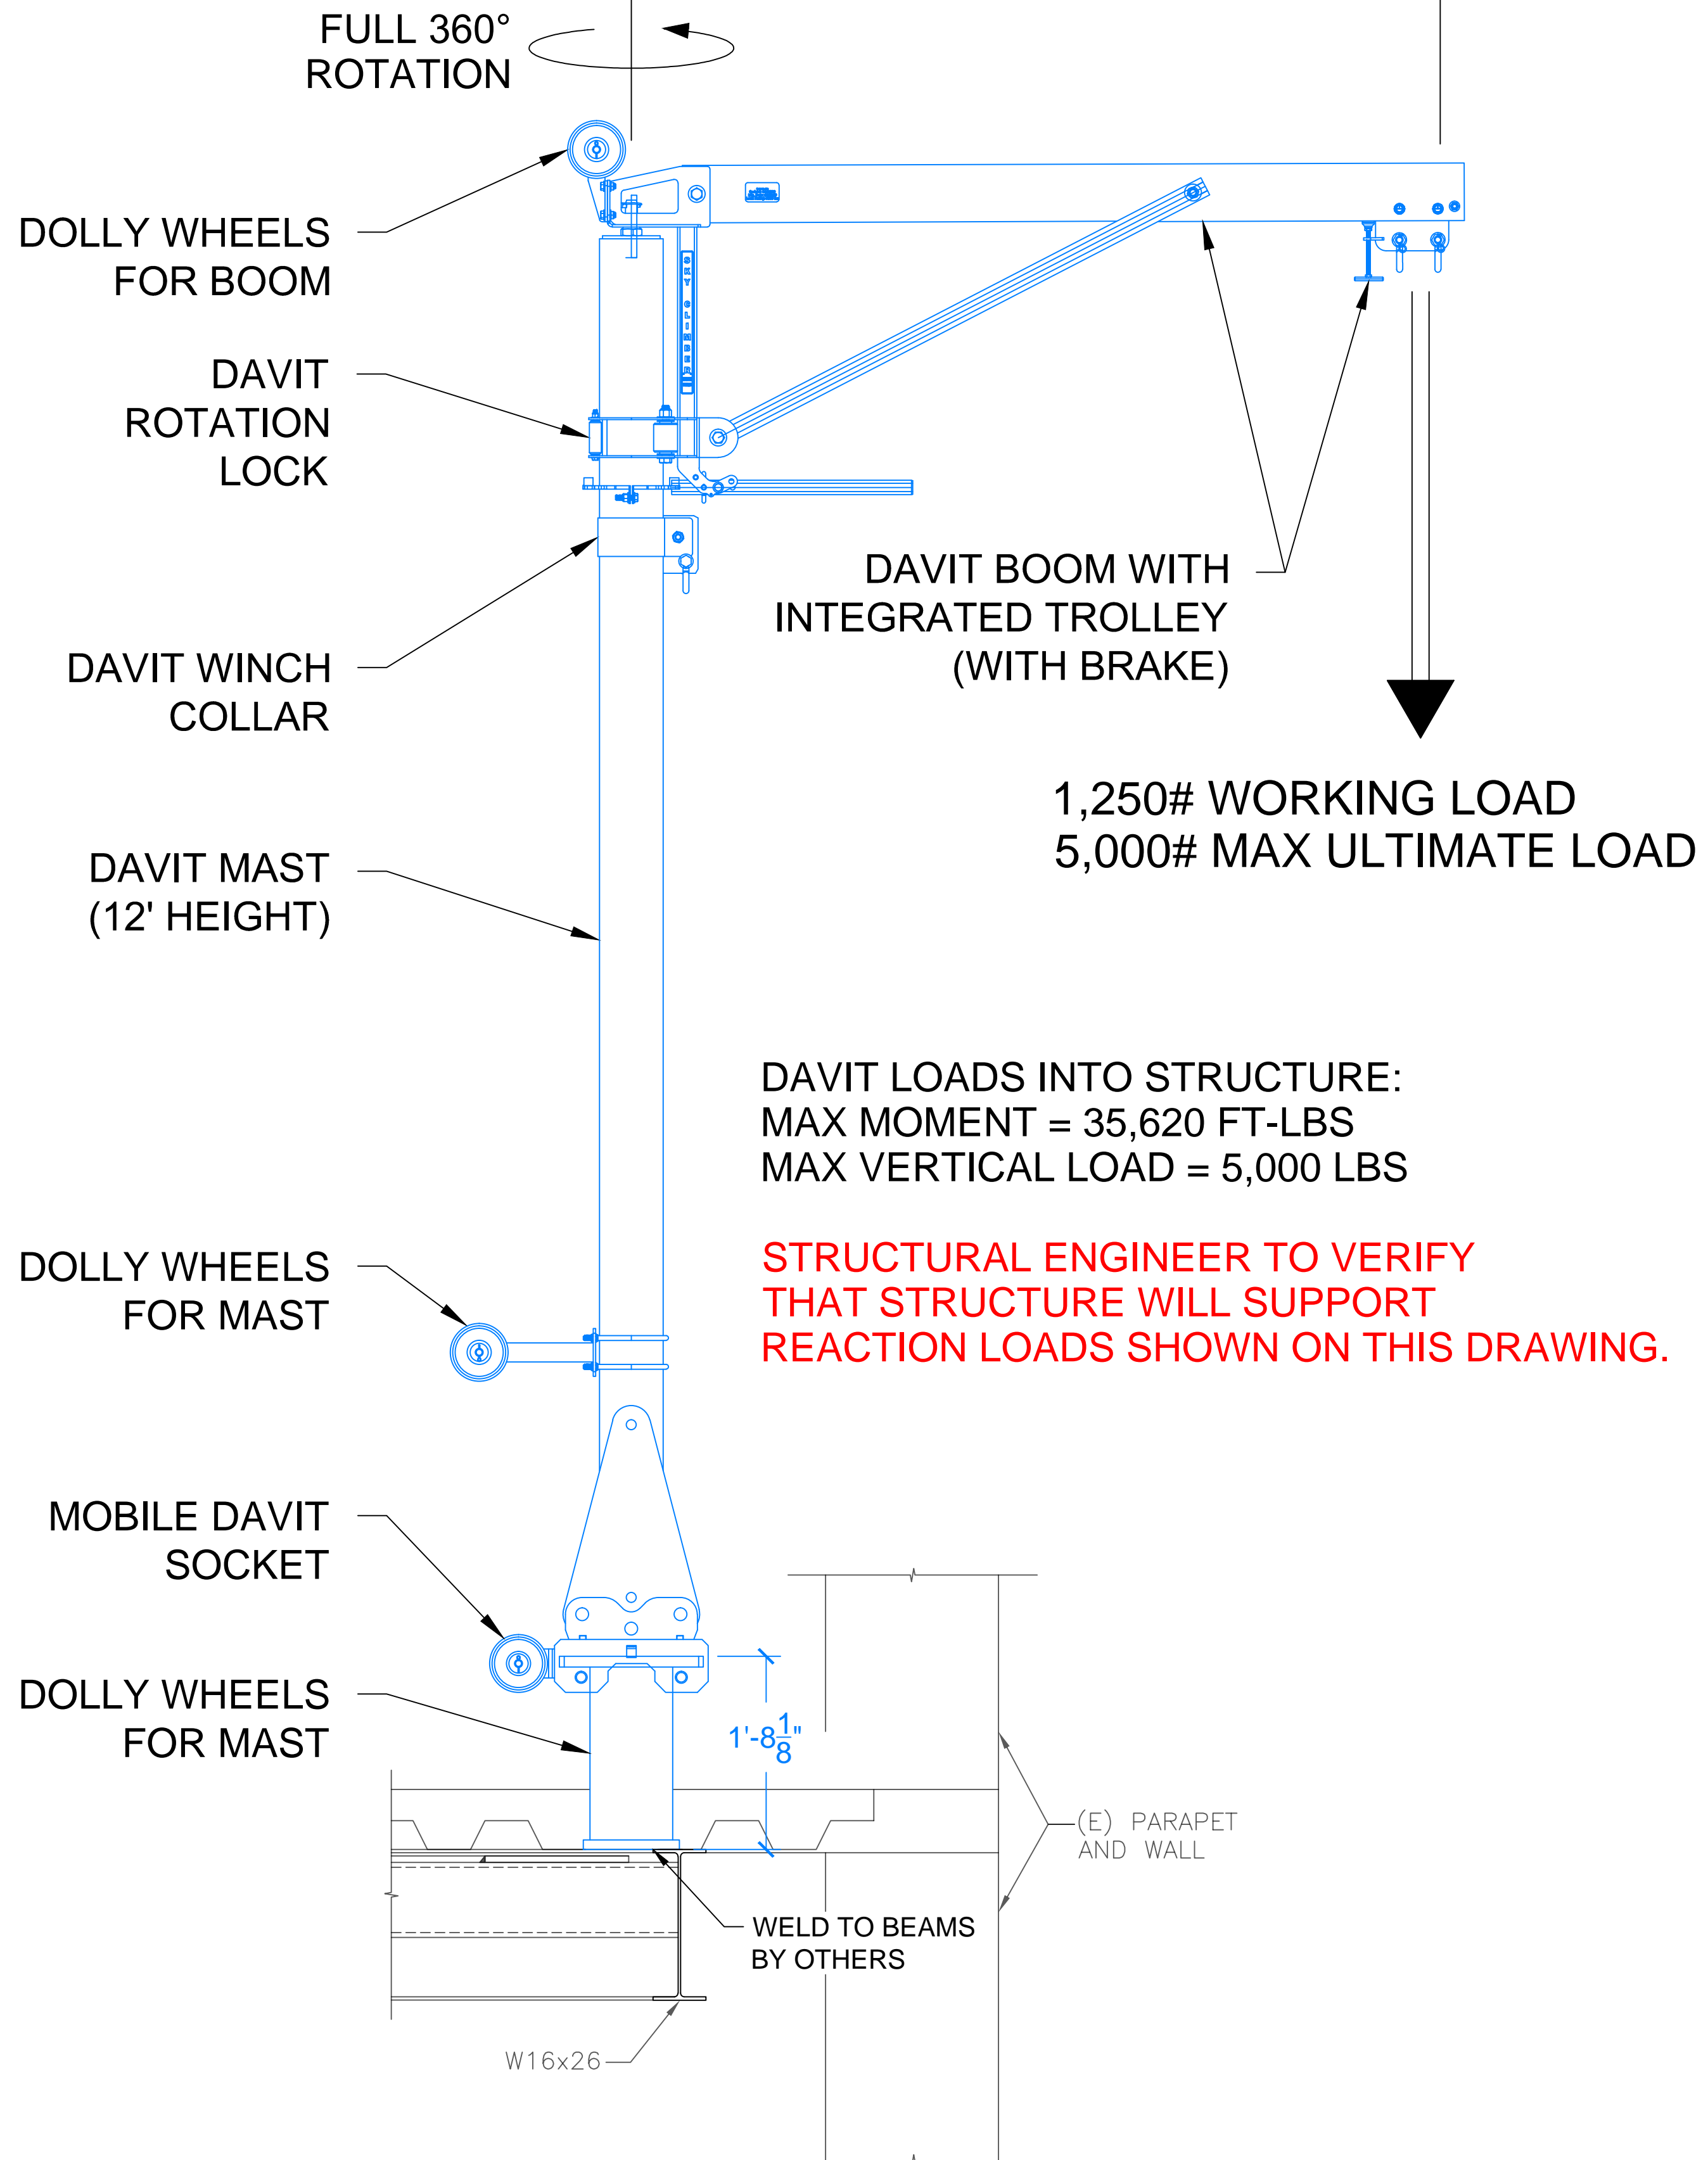

Sky Climber®, LLC
1800 Pittsburgh Drive, Delaware, OH 43015
Toll Free: 800.255.4629 Ph: 740.203.3900 Fax: 740.203.3901
E-mail: info@skyclimber.com Web: www.skyclimber.com

PROJECT
UC HASTINGS
SAN FRANCISCO, CA

SHEET TITLE
DAVIT ASSEMBLY DETAILS


REV.	DESCRIPTION	DATE	REV. BY
A	INITIAL RELEASE	9-19-18	MB

DATE: 9-19-18 DRAWN BY: MB
SCALE: CHECKED BY:
PROJECT #:
SHEET #: SCL 2.1 REVISION #: A

1 TYP. DAVIT ASSEMBLY DETAIL AT W30 BEAM

2 TYP. DAVIT ASSEMBLY DETAIL AT W16 BEAM

IMPOSED LOADS ON DAVIT BASE:
 MAX MOMENT = 35,620 FT-LBS = M_{ULT}
 MAX VERTICAL LOAD = 5,000 LBS = R_{ULT}

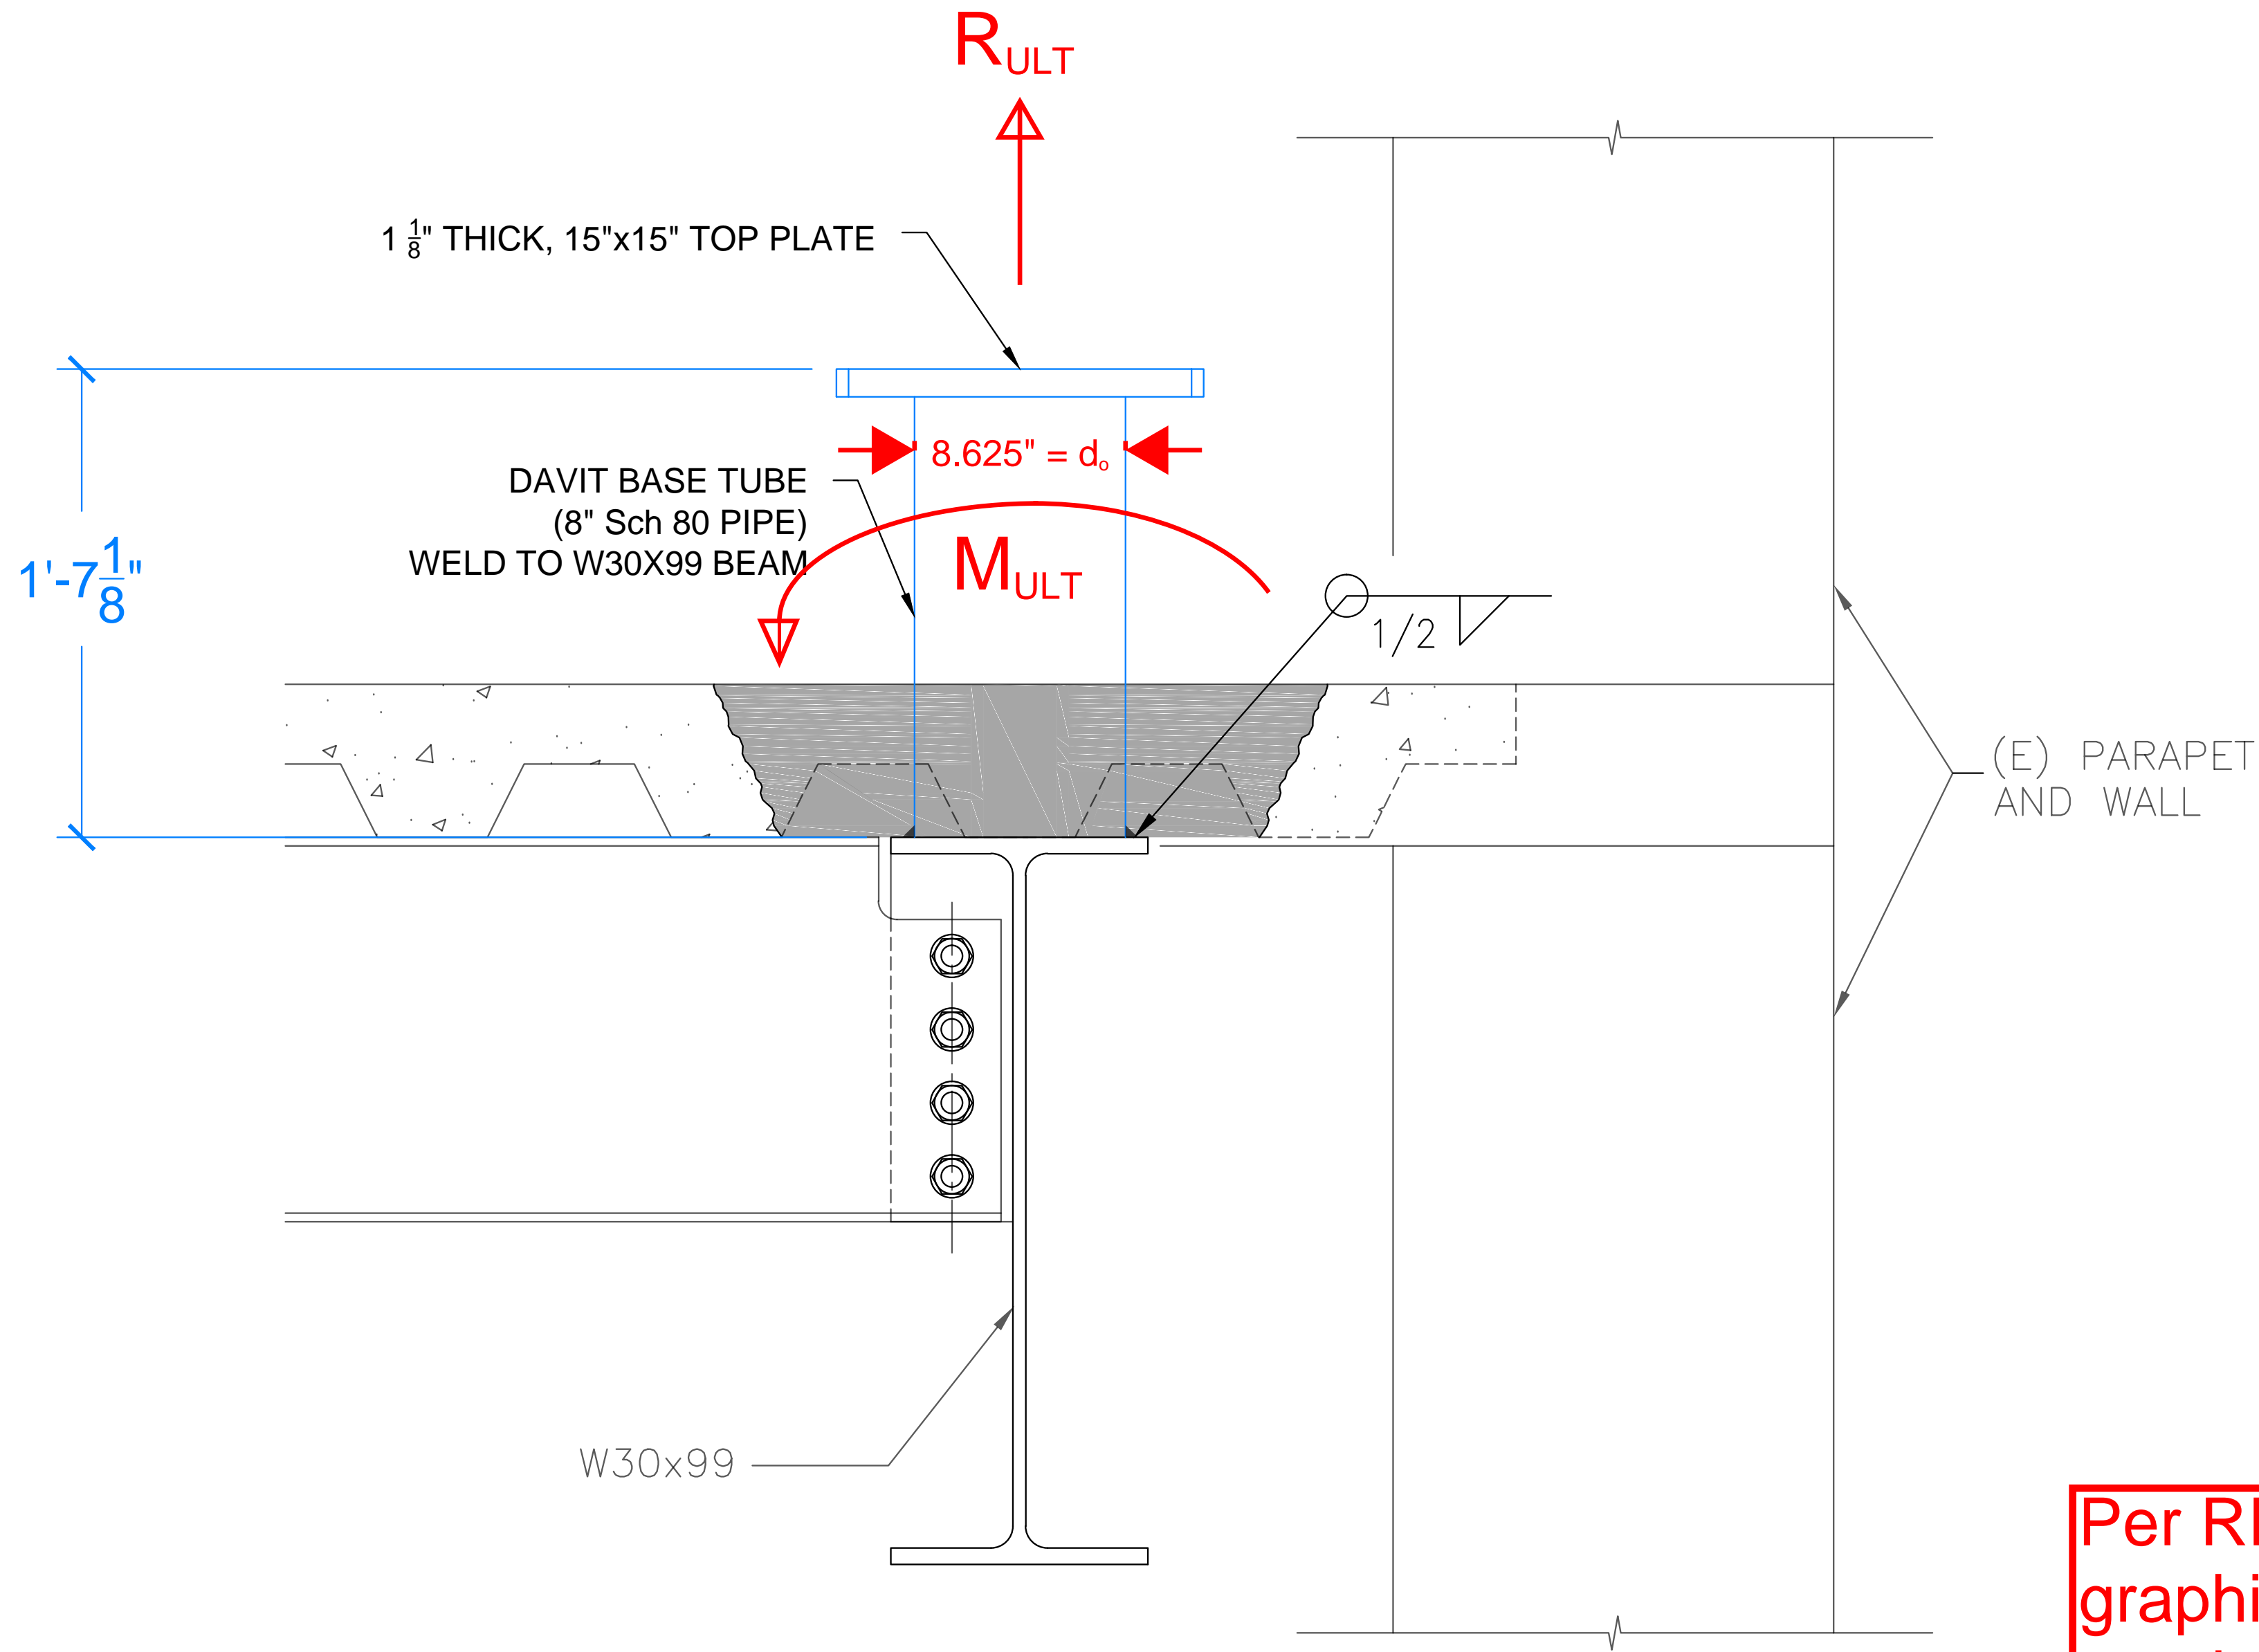

$M_{ULT} = 35,620 \text{ ft-lbs} = 427,440 \text{ in-lbs}$
 $R_{ULT} = 5,000 \text{ lbs}$

$t_w = \text{fillet weld size} = 0.5"$

$s_w = \text{section modulus of weld / in}$
 $s_w = \pi(d_o)^2 / 4 = \pi(8.625")^2 / 4 = 58.426 \text{ in}^2$

$S_1 = \text{stress on weld from moment}$
 $S_1 = M_{ULT} / (s_w * t_w * 0.707) = 20,696 \text{ psi}$

$S_2 = \text{stress on weld from vertical load}$
 $S_2 = R_{ULT} / (\pi * d_o * 0.707 * t_w) = 522 \text{ psi}$

$S_{MAX} = (S_1^2 + S_2^2)^{1/2} = 20,703 \text{ psi}$

$F_{U,weld} = \text{ultimate stress of weld}$
 $F_{U,weld} = 70 \text{ ksi (E70xx electrode, min.)}$

$F_{A,weld} = \text{allowable stress of weld}$
 $F_{A,weld} = .6(F_{U,weld}) = 42 \text{ ksi}$

$S_{MAX} < F_{A,weld} \dots \text{OK}$

Per RFI #009, this sheet shall be eliminated. The graphic is inconsistent with the structural details required.



Small text providing Sky Climber, LLC contact information: 1800 Pittsburgh Drive, Delaware, OH 43015. Toll Free: 800.255.4629. Ph: 740.203.3900. Fax: 740.203.3901. E-mail: info@skyclimber.com. Web: www.skyclimber.com

PROJECT

UC HASTINGS
 SAN FRANCISCO, CA

SHEET TITLE

DAVIT BASE
 WELD CALCULATIONS


REVISIONS

REV.	DESCRIPTION	DATE	REV. BY
A	INITIAL RELEASE	3-6-18	NK

DATE:	3-6-18	DRAWN BY:	NK
SCALE:		CHECKED BY:	
PROJECT #:			
SHEET #:	SCL 3.0	REVISION #:	A


SKY CLIMBER CALCULATION PACKAGE

PROJECT: PI Sockets
ENGINEER: Nick Slee
DATE: 8-Jun-18
DESCRIPTION: Davit Socket Base, Mobile, 1250# Capacity
DRAWING NO: DVT-SB-MOB
SPECS: 1250 lb. Capacity

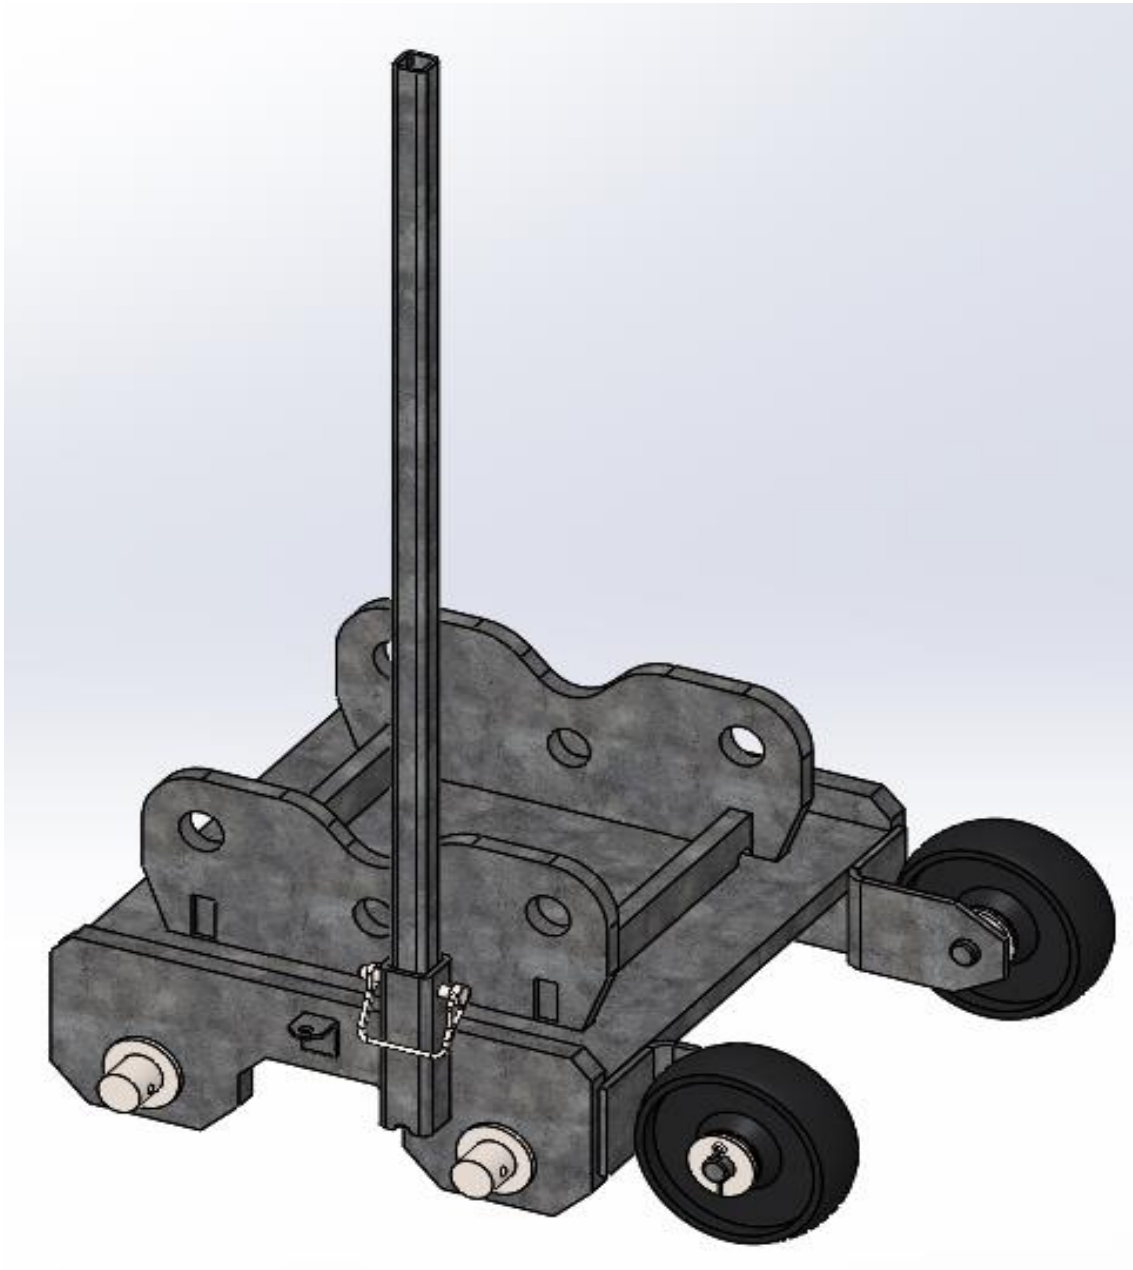

Sky Climber Model: DVT-SB-MOB

Application: Mobile Socket Base

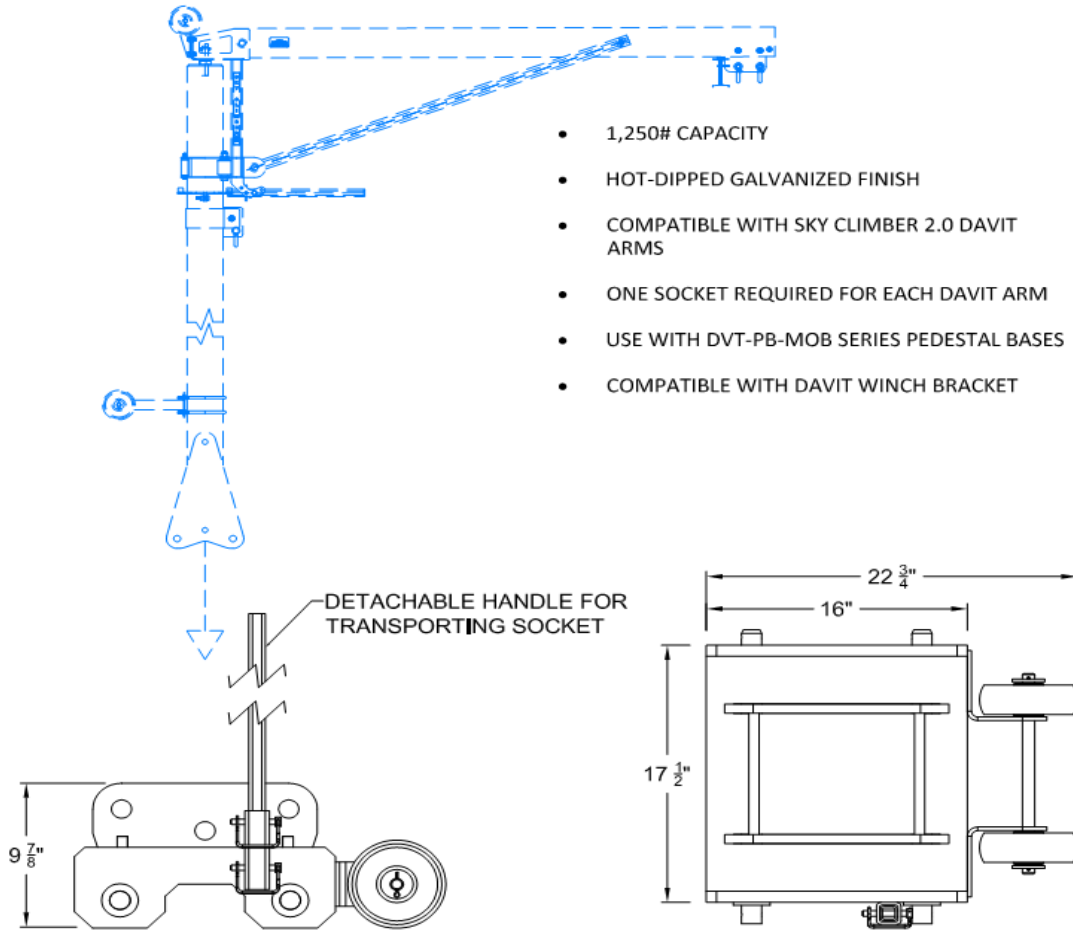

NOTE:

DAVIT IS CAPABLE OF SUPPORTING 5,000 LB. ULTIMATE LOAD AND 1,250 LB. ALLOWABLE LOAD. DAVIT MAY FAIL DUE TO IMPROPER INSTALLATION OR INADEQUATE SUPPORTING STRUCTURE. SERIOUS INJURY OR DEATH MAY RESULT FROM DAVIT FAILURE. INSTALLATION OF DAVIT MUST BE PERFORMED UNDER THE SUPERVISION OF A PROFESSIONAL ENGINEER WITH EXPERIENCE IN SUSPENDED ACCESS EQUIPMENT. ADDITIONALLY, DAVIT SHALL BE TESTED UNDER THE SUPERVISION OF A P.E. AND CERTIFIED BEFORE PLACING INTO SERVICE.

SPECIFIC CONSTRUCTION DETAILS AND APPLICATIONS VARY. THE STRUCTURE THE DAVIT BASE IS ATTACHED TO MUST BE ADEQUATE TO SUPPORT THE REQUIRED LOADING. THEREFORE, ALL INSTALLATION DETAILS MUST BE CONFIRMED BY THE BUILDING'S ENGINEER OF RECORD PRIOR TO THE INSTALLATION.

Portable Socket

Loading Conditions

d	=	10.25 (in)	Davit pin spacing
M _{max}	=	520625 (in-lbs)	maximum moment from davit
T _{pin}	=	50793 (lbs)	Load on pin

ASTM A500 Grade B Steel

E	=	29000 (ksi)
F _{tu}	=	60 (ksi)
F _{ty} , F _{cy}	=	46 (ksi)
K	=	1 (-)

Calculations

AISC Table J3.4

d _{pin}	=	1.250 (in)	Diameter of pin
L _{edge}	=	1.63 (in)	Minimum Required Edge Distance
L _c	=	1.63 (in)	Actual Edge Distance

Base/Socket Pin Hole Edge Distance

$$L_c \geq L_{edge} \quad \text{PASS}$$

AISC Section J3.10

t	=	0.625 (in)	Plate Thickness
R _n	=	91406 (lbs)	Eqn. J3-6b
R _{max}	=	25396 (lbs)	[T _{pin} /2], Pin is in double shear

Base/Davit Pin Hole Bearing/Tearout Strength

$$R_{max} < R_n \quad \text{PASS}$$

AISC Section J2

h	=	0.5 (in)
d	=	12 (in)
I	=	203.6 (in ³)
τ	=	15.3 (ksi)
τ _{allow}	=	34.6 (ksi)

Weld Strength

$$\tau < \tau_{allow} \quad \text{PASS}$$

Socket Pin- 1.25" Round Bar

Section Properties

d_{pin}	=	1.25 (in)
A	=	1.227 (in ²)
I	=	0.120 (in ⁴)
S	=	0.192 (in ³)
Z	=	0.326 (in ³)

Loading Conditions

a	=	0.250 (in)
d	=	10.25 (in)
M_{max}	=	520625 (in-lbs)
T_{pin}	=	50793 (lbs)
M_{max}	=	6349 (in-lbs)
$\sigma_{b, max}$	=	33.1 (ksi)

Distance between support and load pin spacing
 maximum moment from davit
 Resolved moment on pin
 maximum bending moment on pin
 bending stress on pin

Calculations

AISC Section F11.1

M_1	=	13021 (in-lbs)
M_2	=	11505 (in-lbs)
M_n	=	11505 (in-lbs)

$$M_{max} < M_n \quad \text{PASS}$$

AISC Section G.4

V	=	25396 (lbs)
V_n	=	29452 (lbs)

$$V < V_n \quad \text{PASS}$$


Flexural Strength to Yield

Elements- Shear

pin in double shear
 Max allowable shear load

416 Stainless Steel Properties

F_{tu}	=	70 (ksi)	-
F_{ty}, F_{cy}	=	40 (ksi)	-
F_{sy}	=	24 (ksi)	-

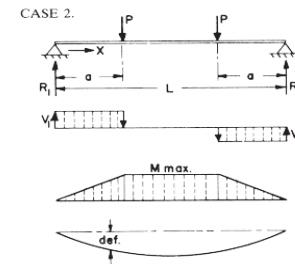

Two equal concentrated loads P equi-distant from the center

Reactions: $R_1 = R_2 = P$

Maximum shear forces: $V_1 = +P; V_2 = -P$

Maximum bending moment: $M_{max} = Pa$, between loads

Maximum deflection = $\frac{Pa}{24EI} (3L^2 - 4a^2)$

def. = $\frac{Px}{6EI} (3La - 3a^2 - x^2)$, $0 \leq x \leq a$

= $\frac{Pa}{6EI} (3Lx - 3x^2 - a^2)$, $a \leq x \leq (L - a)$


SKY CLIMBER CALCULATION PACKAGE

PROJECT: PI Davits
ENGINEER: Nick Slee
DATE: 21-Apr-17
DESCRIPTION: Davit 2.0, 12' Tall, 8.5' OR
DRAWING NO: DVT-RR-8-HD-2.0
SPECS: 1250# Capacity, 8.5' Outreach, 12' Tall



Sky Climber Model: DVT-RR-8

Application: Roof Rigged, Top Rotating Davit Arm

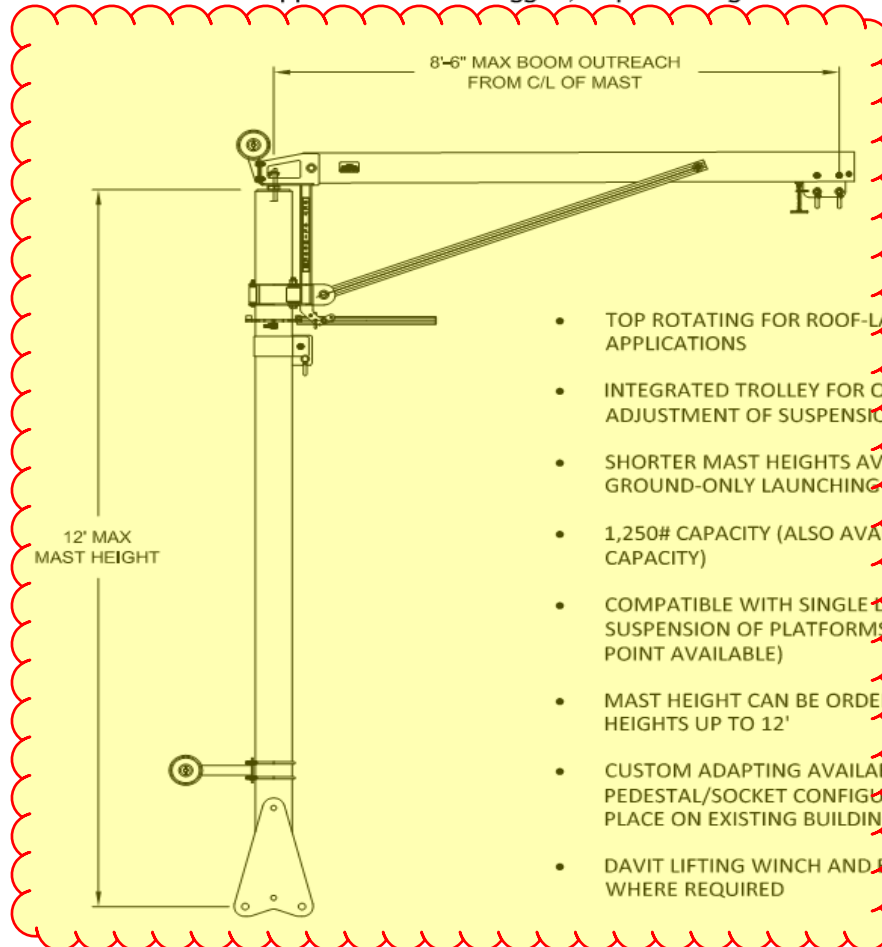

RS/SRS: VERIFY FULLY ASSEMBLED PORTABLE DAVIT ARM IS LESS THAN 300 LBS.

- TOP ROTATING FOR ROOF-LAUNCHED APPLICATIONS
- INTEGRATED TROLLEY FOR QUICK AND EASY ADJUSTMENT OF SUSPENSION POINT / OUTREACH
- SHORTER MAST HEIGHTS AVAILABLE FOR GROUND-ONLY LAUNCHING APPLICATIONS
- 1,250# CAPACITY (ALSO AVAILABLE IN 1,000# CAPACITY)
- COMPATIBLE WITH SINGLE LINE AND TWO LINE SUSPENSION OF PLATFORMS (2ND SUSPENSION POINT AVAILABLE)
- MAST HEIGHT CAN BE ORDERED IN CUSTOM HEIGHTS UP TO 12'
- CUSTOM ADAPTING AVAILABLE FOR MANY PEDESTAL/SOCKET CONFIGURATIONS ALREADY IN PLACE ON EXISTING BUILDINGS
- DAVIT LIFTING WINCH AND BRACKET AVAILABLE WHERE REQUIRED

NOTE:

DAVIT IS CAPABLE OF SUPPORTING 5,000 LB. ULTIMATE LOAD AND 1,250 LB. ALLOWABLE LOAD. DAVIT MAY FAIL DUE TO IMPROPER INSTALLATION OR INADEQUATE SUPPORTING STRUCTURE. SERIOUS INJURY OR DEATH MAY RESULT FROM DAVIT FAILURE. INSTALLATION OF DAVIT MUST BE PERFORMED UNDER THE SUPERVISION OF A PROFESSIONAL ENGINEER WITH EXPERIENCE IN SUSPENDED ACCESS EQUIPMENT. ADDITIONALLY, DAVIT SHALL BE TESTED UNDER THE SUPERVISION OF A P.E. AND CERTIFIED BEFORE PLACING INTO SERVICE.

SPECIFIC CONSTRUCTION DETAILS AND APPLICATIONS VARY. THE STRUCTURE THE DAVIT BASE IS ATTACHED TO MUST BE ADEQUATE TO SUPPORT THE REQUIRED LOADING. THEREFORE, ALL INSTALLATION DETAILS MUST BE CONFIRMED BY THE BUILDING'S ENGINEER OF RECORD PRIOR TO THE INSTALLATION.

Beam: 6" X 4" X 0.25"

Section Properties

b	=	4 (in)
h	=	6 (in)
t	=	0.25 (in)
A	=	4.617 (in ²)
I _x	=	22.344 (in ⁴)
I _y	=	12.346 (in ⁴)
S _{x,t}	=	7.659 (in ³)
S _{x,c}	=	7.248 (in ³)
r _y	=	2.20 (in)
Z	=	9.142 (in ³)

Loading Conditions

a	=	26.625 (in)
L	=	77.5 (in)
P	=	1250 (lbs)
F.O.S.	=	4 (-)
M _{max}	=	133125 (in-lbs)
σ _{b, max}	=	17.381 (ksi)

Calculations


ADM Section F.2

M ₁	=	319970 (in-lbs)
M ₂	=	402105 (in-lbs)
M ₃	=	380530 (in-lbs)
M _{np}	=	319970 (in-lbs)

M_{max} < M_{np} PASS

ADM Section J.3.6


D	=	0.75 (in)
---	---	-----------

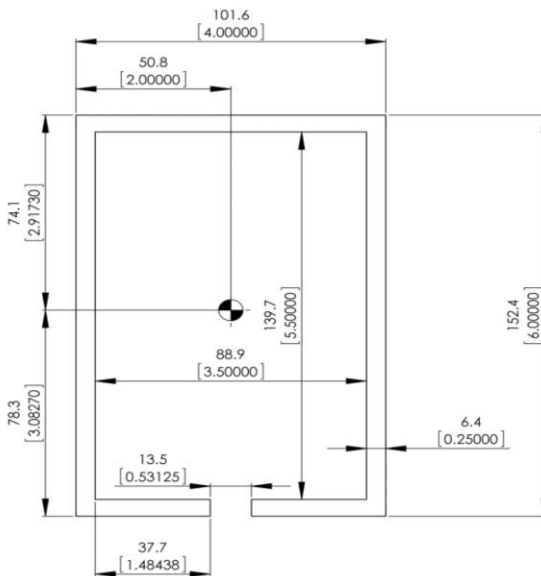

6061-T6 Aluminum Properties

E	=	10100 (ksi)	- Table A.3.4
F _{tu}	=	38 (ksi)	- Table A.3.4
F _{ty} , F _{cy}	=	35 (ksi)	- Table A.3.4
k _t	=	1 (-)	- Table A.3.3
F _{sy}	=	21 (ksi)	-

CASE 20.

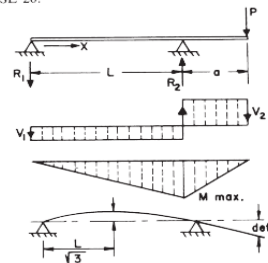

Concentrated load, P, at end of overhang

Reactions: $R_1 = -\frac{Pa}{L}$
 $R_2 = \frac{P}{L}(L + a)$

Shear forces: $V_1 = -\frac{Pa}{L}$
 $V_2 = P$

Maximum bending moment:
 $M_{max} = -Pa$, at right support

Deflections:
 Maximum downward def. = $\frac{Pa^2}{3EI}(L + a)$, at load
 Maximum upward deflection; at $x = \frac{L}{\sqrt{3}}$
 $= \frac{PaL^2}{9\sqrt{3}EI} = 0.06415 \frac{PaL^2}{EI}$

Flexural Strength to Yield

Bearing Strength at Bolt

Diameter of Bolt

t_w	=	0.250 (in)	Thickness of beam
d_e	=	3.000 (in)	bolt edge distance
R_n	=	28500 (lbs)	J.3-4 Equation- Bearing Strength
R_n	=	28500 (lbs)	J.3-4 Equation-Edge Distance
P_{pin}	=	6718 (lbs)	

$P_{pin} < R_n$ PASS

ADM Section G.2

Elements- Shear

B_s	=	27.2 (ksi)	Table 1-1
D_s	=	0.141 (ksi)	Table 1-1
λ_1	=	35	
b/t	=	22	
F_s	=	21 (ksi)	$b/t < \lambda_1$
F_{so}	=	1.46 (ksi)	$F_{so} = V_{max}/A = R_2/A$

$F_{so} < F_s$ PASS

ADM Section B.5.4.2

Elements- Uniform Compression

b/t	=	22 (-)	
B_p	=	45 (ksi)	Table 1-1
D_p	=	0.3 (ksi)	Table 1-1
λ_1	=	20.83 (-)	
λ_2	=	32.81 (-)	
k_1	=	0.35 (-)	Table B.4.3
F_c	=	34.44 (ksi)	$\lambda_1 < b/t < \lambda_2$

$\sigma_{b, max} < F_c$ PASS

ADM Section B.5.5.1

Elements- Flexural Compression

b/t	=	22 (-)	
B_{br}	=	66.8 (ksi)	Table 1-1
D_{br}	=	0.666 (ksi)	Table 1-1

c_o/c_c	=	-1 (-)	
m	=	0.65 (-)	$-c_o=c_c$
λ_1	=	33.03 (-)	
λ_2	=	54.01 (-)	
k_1	=	0.35 (-)	Table B.4.3
F_b	=	52.5 (ksi)	$b/t < \lambda_1$

$\sigma_{b, \max} < F_b$ PASS

ADM Section F.4

Lateral Torsional Buckling

C_b	=	1.3 (-)	Section F.4.1
λ	=	8.8 (-)	Section F.4.2.3
C_c	=	66.0 (-)	Table 1-1
M_{nmb}	=	300577 (in-lbs)	$\lambda < C_c$

$M_{\max} < M_{nmb}$ PASS

Mast: 8" SCH 40 Pipe

Section Properties

A	=	8.400 (in ²)
d _{y,bolt}	=	18.000 (in)
d _{y,pin}	=	10.250 (in)
OD	=	8.625 (in)
L _{pipe}	=	66.000 (in)
r	=	2.940 (in)
I _{x,ly}	=	72.500 (in ⁴)
S	=	16.812 (in ³)
Z	=	22.210 (in ³)
t	=	0.322 (in)
R _b /t	=	12.9 (in)

mast bolt spacing
 mast pin spacing on adapter plate
 Pipe OD

6061-T6 Aluminum Properties


E	=	10100 (ksi)	- Table A.3.4
F _{tu}	=	38 (ksi)	- Table A.3.4
F _{ty} , F _{cy}	=	35 (ksi)	- Table A.3.4
k _t	=	1 (-)	- Table A.3.3

Loading Conditions

a	=	26.625 (in)
L	=	77.5 (in)
P	=	1250 (lbs)
F.O.S.	=	4 (-)
R	=	5000 (lbs)
M _{max}	=	520625 (in-lbs)
T _{bolt}	=	14516 (lbs)
T _{pin}	=	25427 (lbs)
σ _{b, max}	=	30.97 (ksi)

4:1 Required F.O.S.

Load on adapter plate bolts
 Load on davit pins

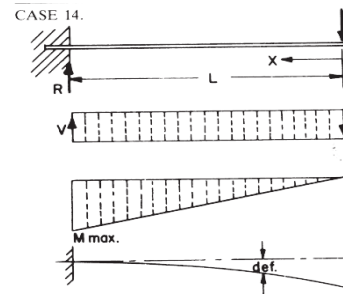

Concentrated load, P, at free end of cantilever beam

Reaction: R = P, at fixed end

Shear force V = -P, 0 ≤ x ≤ L

Maximum bending moment = -PL, x = L

Bending moment: M = -Px, 0 ≤ x ≤ L

Maximum deflection = $\frac{PL^3}{3EI}$, at free end, x = 0

def. = $\frac{P}{6EI} (2L^3 - 3L^2x + x^3)$, 0 ≤ x ≤ L

Calculations

ADM Section F.2

M ₁	=	777341 (in-lbs)
M ₂	=	882609 (in-lbs)
M ₃	=	882609 (in-lbs)
M _{np}	=	777341 (in-lbs)

Flexural Strength to Yield

$M_{max} < M_{np}$ PASS

ADM Section B.5.4.5

Elements- Uniform Compression

R_b/t	=	12.9 (-)	
B_t	=	43.2 (ksi)	Table 1-1
C_t	=	141 (-)	Table 1-1
D_t	=	1.558 (ksi)	Table 1-1
λ_1	=	27.70 (-)	
F_c	=	35 (ksi)	$R_b/t < \lambda_1$

$\sigma_{b, max} < F_c$ PASS

ADM Section B.5.5.4

Elements- Flexural Compression

R_b/t	=	12.9 (-)	
B_{tb}	=	64.8 (ksi)	Table 1-1
C_{tb}	=	55.4 (-)	Table 1-1
D_{tb}	=	4.46 (ksi)	Table 1-1
λ_1	=	55.40 (-)	
F_b	=	48.79 (ksi)	$R_b/t < \lambda_1$

$\sigma_{b, max} < F_b$ PASS

ADM Section E.2

Member Buckling

λ	=	22.4 (-)	
B_c	=	39.4 (ksi)	Table 1-1
D_c	=	0.246 (ksi)	Table 1-1
λ_1	=	17.89 (-)	
λ_2	=	66.00 (-)	$\lambda_2 = C_c$
F_c	=	33.40 (ksi)	$\lambda_1 < \lambda < \lambda_2$
P_{nc}	=	280523 (lbs)	

$R < P_{nc}$ PASS

ADM Section H.1**Combined Flexure and Axial Forces**

P_R/P_C	=	0.018 (-)	
M_R/M_C	=	0.670 (-)	Table 1-1
$P_R/P_C + M_R/M_C$	=	0.688 (-)	Table 1-1

$P_R/P_C + M_R/M_C < 1.0$ PASS

ADM Section J.3.6**Bearing Strength at Mast Bolt**

D	=	1 (in)	Diameter of Bolt
t	=	0.322 (in)	Thickness of mast wall
d_e	=	2.125 (in)	bolt edge distance
R_n	=	24472 (lbs)	J.3-4 Equation- Bearing Strength
R_n	=	26002 (lbs)	J.3-4 Equation-Edge Distance
T_{bolt}	=	14516 (lbs)	

$T_{bolt} < R_n$ PASS

ADM Section J.3.6**Bearing Strength at Davit Pin (Adapter Plate)**

D	=	1.25 (in)	Diameter of Pin
t	=	0.375 (in)	Thickness of adapter plate
d_e	=	1.875 (in)	Pin edge distance
R_n	=	35625 (lbs)	J.3-4 Equation- Bearing Strength
R_n	=	26719 (lbs)	J.3-4 Equation-Edge Distance
T_{pin}	=	25427 (lbs)	

$T_{pin} < R_n$ PASS

AISC Section J3.6**Bolt Shear Strength**

tpi	=	8.00 (-)	threads per inch
A_b	=	0.61 (in ²)	nominal unthreaded body area of bolt
F_n	=	70 (ksi)	bolt tensile strength
F_{nv}	=	42 (ksi)	bolt shear strength (60% of bolt tensile strength)

$$R_n = 25441 \text{ (lbs)} \quad \text{Eqn. J3-1}$$

$T_{\text{bolt}} < R_n$ PASS

Brace: 2" X 2" X .125" Tube

Section Properties

b	=	2 (in)
t	=	0.125 (in)
A	=	0.840 (in ²)
I	=	0.486 (in ⁴)
S	=	0.486 (in ³)
r	=	0.761 (in)

Loading Conditions

a	=	26.625 (in)
L	=	77.5 (in)
L _c	=	72.125 (in)
P	=	1250 (lbs)
F.O.S.	=	4 (-)
R ₂	=	6718 (lbs)
Θ	=	21 (deg)
P	=	18745 (lbs)
σ _{c, max}	=	22.32 (ksi)

Length of brace

Calculations

AISC Section J3.5

d _{bolt}	=	0.75 (in)
L _{edge}	=	1.00 (in)
L _{act}	=	1.4375 (in)

L_{edge} < L_{act} PASS

AISC Section J3.10

l _c	=	1.0469 (in)
t	=	0.125 (in)
d _{bolt}	=	0.75 (in)

Bolt Hole Edge Distance

Diameter of bolt
Minimum Required Edge Distance
Actual Edge Distance


Bolt Hole Bearing and Tearout Strength

Upper Plate Thickness
Diameter of bolt

A500 Gr B Properties

E	=	29000 (ksi)
F _{tu}	=	58 (ksi)
F _{ty} , F _{cy}	=	45.7 (ksi)
k _t	=	1 (-)

CASE 20.

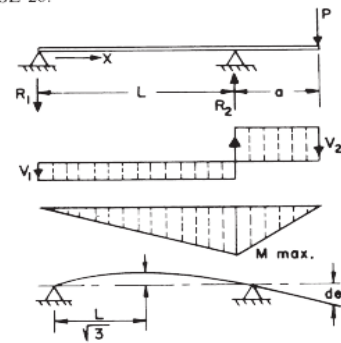

Concentrated load, P, at end of overhang

Reactions: $R_1 = -\frac{Pa}{L}$

$R_2 = \frac{P}{L}(L + a)$

Shear forces: $V_1 = -\frac{Pa}{L}$
 $V_2 = P$

Maximum bending moment:
 $M_{max} = -Pa$, at right support

Deflections:
 Maximum downward def. = $\frac{Pa^2}{3EI}(L + a)$, at load

Maximum upward deflection; at $x = \frac{L}{\sqrt{3}}$
 $= \frac{PaL^2}{9\sqrt{3}EI} = 0.06415 \frac{PaL^2}{EI}$

$$R_n = 11385 \text{ (lbs)} \quad \text{Eqn. J3-6b}$$

$$R_{\max} = 9373 \text{ (lbs)} \quad [P/2], \text{ Bolt is in double shear}$$

$$R_{\max} < R_n \quad \text{PASS}$$

AISC Section J3.6

Bolt Shear Strength

$$\text{tpi} = 10.00 \text{ (-)} \quad \text{threads per inch}$$

$$A_b = 0.33 \text{ (in}^2\text{)} \quad \text{nominal unthreaded body area of bolt}$$

$$F_n = 70 \text{ (ksi)} \quad \text{bolt tensile strength}$$

$$F_{nv} = 42 \text{ (ksi)} \quad \text{bolt shear strength (60\% of bolt tensile strength)}$$

$$R_n = 14047 \text{ (lbs)} \quad \text{Eqn. J3-1}$$

$$R_{\max} < R_n \quad \text{PASS} \quad \text{Bolt in double shear}$$

AISC Section E3

Member Buckling

$$KL/r = 94.8 \text{ (-)}$$

$$F_e = 31.833 \text{ (ksi)} \quad \text{Table 1-1}$$

$$F_y/F_e = 1.4 \text{ (-)} \quad \text{Table 1-1}$$

$$F_{cr} = 27.92 \text{ (ksi)} \quad F_y/F_e < 2.25$$

$$P_n = 33236 \text{ (lbs)}$$

$$R < P_n \quad \text{PASS}$$

AISC Table B4.1a

Width to Thickness Ratios

$$b/t = 16.0 \text{ (-)}$$

$$\lambda = 35.27 \text{ (-)}$$

$$F_c = 46 \text{ (ksi)} \quad b/t < \lambda_1$$

$$\sigma_{c, \max} < F_c \quad \text{PASS}$$

Shaft: 0.75" Round Bar

Section Properties

D	=	0.750 (in)
A	=	0.442 (in ²)
I	=	0.016 (in ⁴)
Loading C	=	0.041 (in ³)
L	=	0.636 (in)

Loading Conditions/Calcs

P	=	1250 (lbs)
FOS	=	4 (-)
M _{max}	=	2215 (in-lbs)
σ _{c, max}	=	53.5 (ksi)

σ_{c, max} < F_{ty} PASS

Plate: 0.5" plate

Section Properties

t	=	0.5 (in)
d	=	0.75 (in)
I _c	=	0.742 (in)

Loading Conditions/Calcs

P	=	5000 (lbs)
R _n	=	46802 (lbs)

P < R_n PASS


AISC Section J10

Bar: 316 SS (Annealed, cold drawn bar)

E	=	28000 (ksi)	-
F _{tu}	=	89.9 (ksi)	-
F _{ty} , F _{cy}	=	60.2 (ksi)	-

Plate: 316L SS (Annealed)

E	=	28000 (ksi)
F _{tu}	=	84.1 (ksi)
F _{ty}	=	42.1 (ksi)

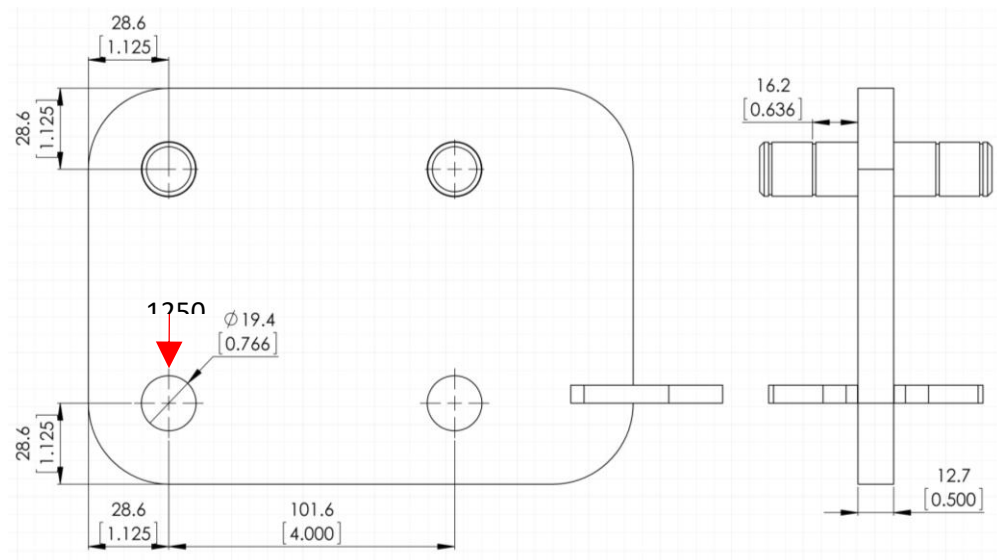

Davit Pin: 1.25" Round Bar

Section Properties

D	=	1.250 (in)	
$d_{y, \text{pin}}$	=	10.250 (in)	mast pin spacing on adapter plate

Loading Conditions

a	=	26.625 (in)	
L	=	77.5 (in)	
P	=	1250 (lbs)	
F.O.S.	=	4 (-)	4:1 Required F.O.S.
M_{max}	=	520625 (in-lbs)	
T_{pin}	=	25427 (lbs)	Load on davit pins

Calculations

AISC Section J3.6

A_b	=	1.23 (in ²)	Area of pin
R_n	=	29452 (lbs)	Eqn. J3-1

$T_{\text{pin}} < R_n$ PASS

416SS Properties

F_y	=	40 (ksi)	Yield Strength
F_s	=	24 (ksi)	Shear Strength